


Section 19 Township 17 Range 14WWell No. #1 ConnersCompany Derby Oil et al

NORTH

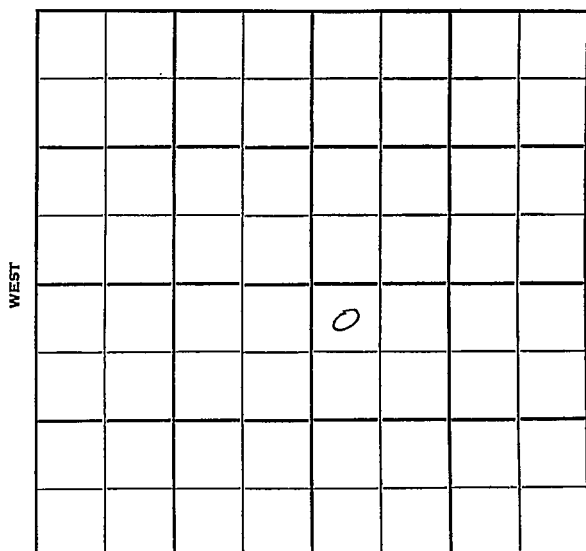

SOUTH

Barton

KANSAS

Sec. 19 Twp. 17 R. 14W ✓

Well No. #1 Conners Farm

Derby Oil et al Company

Semi-Wildcat Contractor


330' Ft. from N. Line

 Ft. from S. Line

 Ft. from E. Line

330' Ft. from W. Line

NW NW SE

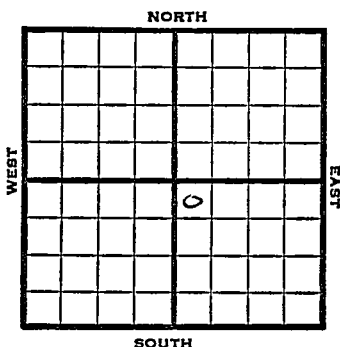

1951

Elev. 1925' REPORT

1/24

Location

2/7

Spud 1-24-51

D&A TD 3505

8" @ 646' Anhy 915

Heeb. 3103 Br Lime 3163


Lans. 3178'

DST 3253-65 opn 1 hr

Rec. 85' mud & sw Long. 3398

Arb. 3473' TD 3505'

D&A **ABANDONED**

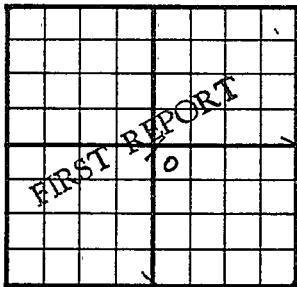
County Barton State KansasSec. 19 (Blk. Twp.) 17 (Sur. Rge.) 14W Map No.Operator Derby Oil etal.Well No. 1 Farm ConnersElev. Location NW NW SE330 Ft. From N Line SE330 Ft. From W Line Quarter1st. Report JAN 24 1951

Completion

Remarks Phillips & Brack DHM

Spudding Date

Drlg. Data Semi WildcatLocation

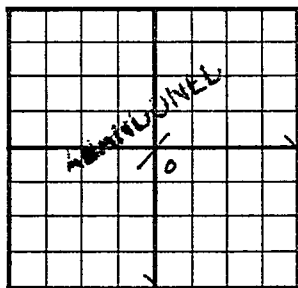County Barton State KansasSec. 19 (Blk. Twp.) 17 (Sur. Rge.) 14W Map No.Operator Derby Oil etal.Well No. 1 Farm ConnersElev. 1925 Location NW NW SE330 Ft. From N Line SE330 Ft. From W Line Quarter

1st. Report

Completion FEB 7 1951Remarks Semi WildcatSpudding Date 1-24-51Drlg. Data D & A TD 35058" @ 646 Anhy 915 Heeb. 3103Br. lime 3163 Lans. 3178 DST 3253-65open 1 hr. Rec. 85' mud & sw Cong. 3398Arb. 3473 TD 3505D & A

J. E. TYRA