

KARAS

Barton

Section 19 Township 17 Range 14W

Well No. 1 Koch

Company B. Brack

Wildcat
NORTH

WEST

EAST

SOUTH

0

Barton

KANSAS ✓

Sec. 19 Twp. 17 R. 14W

Well No. #1 Koch Farm

B. Brack

Company

Wildcat (Brack, Cont.)

NORTH


330' Ft. from N. Line

Ft. from S. Line

Ft. from E. Line

330' Ft. from W. Line

NW/C

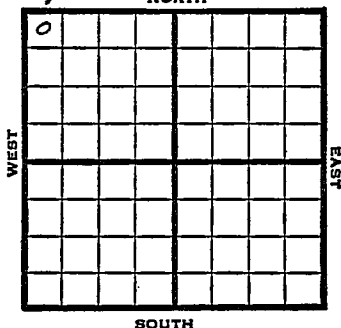

1949

Elev 1906' REPORT

8/10 8" @ 919'
8/17 Lansing 3176'
Drlg 3215'
8/24 Arbuckle 3399'
TD 3411'
5" @ 3400 5" @ 500 acid
s w & 5¢ bbls oil PH 3 hrs.
8/31 "
9/7 "
9/14 "
9/21 TD 3411'
Arb. 3399'
5" @ 3400'
Pump 36 Oil Pot
43° Gr.
Comp

COMPLETED

Map No. _____ Sec. 19 Twp. 17 R. 14W

Well No. 1 Koch

B. Brack Company

Brack Contractor

NW/C

**FIRST REPORT
SECTION PLAT**

330 Ft. from N. Line

_____ Ft. from S. Line

_____ Ft. from E. Line

330 Ft. from W. Line

0			

Barton County

Location _____

Rig up _____

Drilling and Remarks:

8" @ 919

RECORD

Cased _____ in., _____ ft.

Sand _____

Gas _____

Oil _____

Total Depth _____

PRODUCTION

1st 24 hrs. Nat. _____

1st 24 hrs. after shot _____

Gas _____ Cu. Ft.

Dry Hole _____

Abandoned _____

Date

AUG 10 1949

19

S. J. LEWIS

Scout

Kansas

Map No. K73 Sec. 19 Twp. 17 R. 14WWell No. 1 Koch

B. Brack

Company

COMPLETE

Contractor

NW/C

E1, 1906
SECTION PLAT330 Ft. from N. Line

Ft. from S. Line

Ft. from E. Line

330 Ft. from W. Line

6			

Barton County

RECORD

Location

Cased _____ in., _____ ft.

Rig up

Sand _____

Drilling and Remarks:

Gas _____

Oil _____

Total Depth 3411

PRODUCTION

1st 24 hrs. Nat. _____

1st 24 hrs. after shot _____

Gas _____ Cu. Ft.

Dry Hole _____

Abandoned _____

Date

SEP 21 1949 19

S. J. LEWIS

Scout