

Barton

KANSAS

Well No. #1 Hester

Company Rocket Drlg.

NORTH

WEST

EAST

SOUTH

15

D

Barton

KANSAS

SEC.	TWP.	R.
18	17	14W

WELL NO.

#1 Hester

FARM

COMPANY

Rocket Drlg.

CONTRACTOR

Co. Tools.

Axman Pool

Ft. from N. Line


330

Ft. from S. Line

Ft. from E. Line

330

Ft. from W. Line

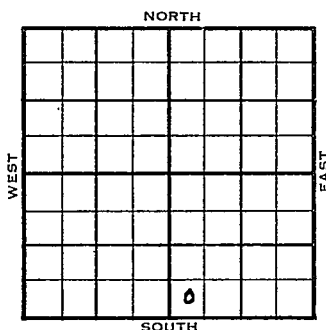

SW SW SE

1955 1879'

ELEVATION

REPORT

1/19 MIR

3/2

Spud 1-19-55

Oil Well

TD 3408'

8" @ 607'

Anhy 845' Heeb 3056' Lans 3122'

DST 3125'-3219' opn 1 hr, rec 870' gas
30' socm, 600' gcm 120' ho & gcm 1060'

DST 3209'-24' opn 2 hr, rec 178' s.w.

970# Ch Cong. 3357' Arb. 3376'

TD 3378'

5" @ 3377'

DD 3381'

B/ 6 goph 4 hr. 500 A S/ 1 bo $\frac{1}{2}$ bwph

6 hr. dec. to 1 bfph 50% Wtr. 12hr.

DD 3387'

S/ 10 goph CO to 3387 B/ 2 goph
1000 A B/ 1 bfph 50% Wtr. DD 3408'

S/ 1 bfph 8 hr. 90% Wtr. PB 3216'

18/ 3136-42 36/ 3146-58 1000 A

S/ 3 boph 17 hr.

Comp 75 bopd.

COMPLETED

FABEN GU STRAP

FABEN GILSTRAP