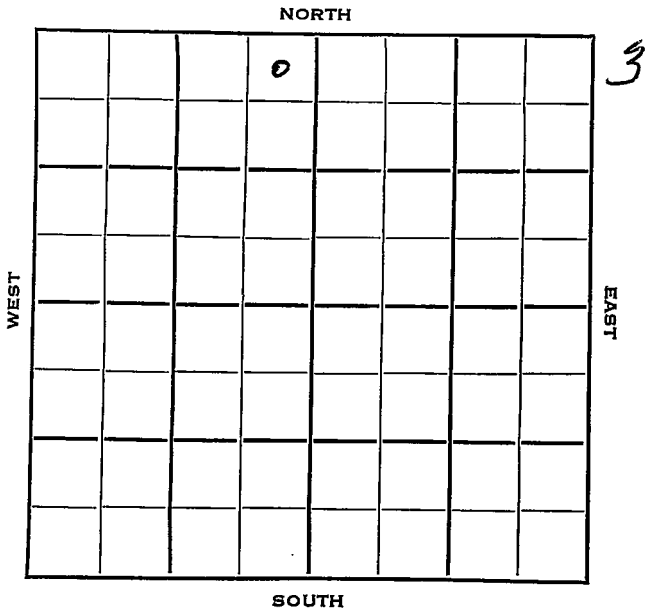


Section 20 Township 17 Range 11WWell No. 1 AxmanCompany W. J. Coppinger

SEC.	TWP.	R.
20	17	14W ✓

WELL NO.

#1 Axman

FARM

COMPANY

W.J. Coppinger

CONTRACTOR

Carroll Pool

330


Ft. from N. Line

Ft. from S. Line

330

Ft. from E. Line

Ft. from W. Line

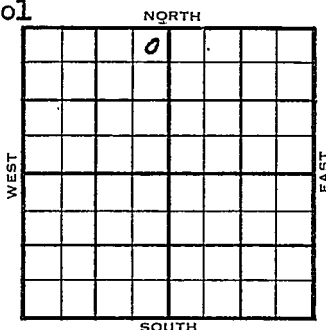

NE NE NW
CSO F/O

1953

ELEVATION

1895'

REPORT

10/28

Spud 10-24-53

8" @ 882'

Drlg 1715'

11/4

Heeb 3074', Br li 3138', Lans 3150'

Drlg. 3300'

11/11

Cong 3350', Arb. 3379'

DST 3383-90', 1 hr., 520' oil, 70'

w & M, 780#

RTD 3420'

5" @ 3419', CO

11/18

CO 3420', 57/3385-3404, 15/3404-09',

FU 1400' wtr., 3/4 hrs., SP 3398'

15/3376-81, 5 goph 150 M-A, 450A

4 boph + 35 bwph 10 hrs.

12/2

Spud 10-24-53

D&A

TD 3420'

8" @ 882'

Heeb 3074', Br lime 3138', Lans 3150',

Cong 3350'

DST 3383-90', opn 1 hr., rec. 520'

oil, 70' wtr & mud, 780#

TD 3420'

5" @ 3419',

CO to 3420'

57/3385-3404', 15/3404-09

OVER

(Information Brought Forward)

1953

12/2

CO to 3420

57/3385-3404', 15/3404-09',

FU 1400' wtr, 3/4 hss.,

SP 3398', 15/3376-81', 5 goph

150 mud-acid, 450A 4 boph 35 bw

sq. perf 3371-81, 100 mud-acid

300A

S/35 boph 145 bw dec. to 5 goph

Arb. 3376'

D&A

ABANDONED

County Barton State Kansas
 Sec. 20 (^{Blk.} ^{Twp.}) 17 (^{Sur.} ^{Rge.}) 14W Map No.
 Operator W. J. Coppinger
 Well No. 1 Farm Axman
 Elev. Location NE NE NW

330 Ft. From N Line NW
330 Ft. From E Line Quarter
 1st. Report OCT 28 1953

Completion

Remarks CSO farmout


Spudding Date 10-24-53

Drlg. Data Carroll Pool

8" @ 882 drlg. 1715

J. G. McGEHEE

County Barton State Kansas
 Sec. 20 (Blk. 17 (Sur. 14W Map No.
 (Twp.) (Rge.)
 Operator W. J. Coppinger
 Well No. 1 Farm Axman
 Elev. 1895 Location NE NE NW

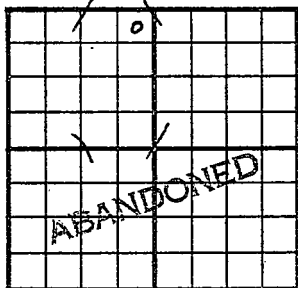

330 Ft. From N Line NW

330 Ft. From E Line Quarter

1st. Report

Completion DEC 2 1953

Remarks Carroll Pool

Spudding Date 10-24-53

Drlg. Data D & A TD 3420

8" @ 882 Heeb. 3074 Br. lime 3138

Lans. 3150 Cong. 3350 ~~3374~~

DST 3383-90 open 1 hr. Rec. 520' oil

70' wtr & mud 780# TD 3420 5" @ 3419

CO to 3420 57/ 3385-3404 15/ 3404-09

FU 1400' wtr. 3/4 hr. SP 3398 15/ 3376-

81 5 goph 150 mud-acid 450 A

4 boph 35 bw sq. perf. 3371-81

100 mud-acid 300 A S/ 35 goph 145 bw

dec. to 5 goph Arb. 3376

D & A

J. G. McGEHEE