

Section 20 Township 17 Range 14 WWell No. #2 DireenCompany Sunray Oil

NORTH

|  |  |  |  |  |  |  |   |
|--|--|--|--|--|--|--|---|
|  |  |  |  |  |  |  |   |
|  |  |  |  |  |  |  | o |
|  |  |  |  |  |  |  |   |
|  |  |  |  |  |  |  |   |
WEST

EAST

SOUTH

Barton

KANSAS

Sec. 20 Twp. 17 R. 14W

Well No. #2 Direen Farm

Sunray Oil Company

Stickle Drlg. - Contr. Contractor


990' Ft. from N. Line

Ft. from S. Line

330' Ft. from E. Line

Ft. from W. Line

SE NE NE

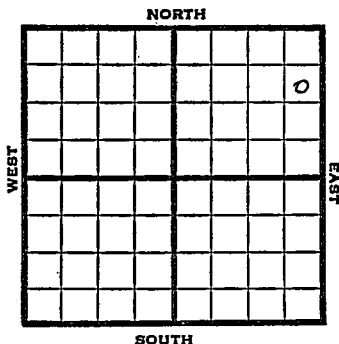

1951

Elev. 1907

REPORT

1/17 Spud 1-16-51  
8" @ 882'

1/31 Spud 1-16-51  
D & A TD 3429  
8" @ 882'

Heeb. 3070 Br. line 3135 Lans. 3143  
Cong. 3369 Arb. 3411

DST 3412-16 Open. 45 min. Rec. d 150'

mud  
DST 3421-29 TD open 1 hr. Rec. 25'

Mud  
D & A

**ABANDONED**

County Barton State Kansas  
 Sec. 20 (Blk. Twp.) 17 (Sur. Rge.) 14W Map No.  
 Operator Sunray Oil  
 Well No. 2 Farm Direen  
 Elev. \_\_\_\_\_ Location SE NE NE

|  |  |  |  |  |  |   |
|--|--|--|--|--|--|---|
|  |  |  |  |  |  |   |
|  |  |  |  |  |  | 0 |
|  |  |  |  |  |  |   |
|  |  |  |  |  |  |   |
|  |  |  |  |  |  |   |
|  |  |  |  |  |  |   |
|  |  |  |  |  |  |   |
|  |  |  |  |  |  |   |


FIRST REPORT

990 Ft. From N Line NE  
330 Ft. From E Line Quarter  
 Ist. Report JAN 17 1951  
 Completion \_\_\_\_\_  
 Remarks Stickle Drlg. - Contr.  
 Spudding Date 1-16-51

Drlg. Data

8" @ 882

J. E. TYRA

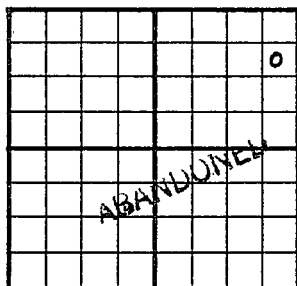County Barton State KansasSec. 20 (Blk. 17 (Sur. 14W Map No. )  
(Twp.) (Rge.)Operator Sunray OilWell No. 2 Farm DireenElev. 1907 Location SE NE NE990 Ft. From N Line NE330 Ft. From E Line Quarter1st. Report Completion JAN 31 1951Remarks Stickle Drlg. - Contr.Spudding Date 1-16-51Drlg. Data D & A TD 34298" @ 882 Heeb. 3070 Br. lime 3135Lans. 3143 Cong. 3369 Arb. 3411DST 3412-16 open 45 min. Rec. 150' mudDST 3421-29 TD open 1 hr. Rec. 25' mudD & A

J. E. TYRA