


Barton KANSAS

Section 20 Township 17 Range 14W

Well No. #3 Direen

Company Sunray Oil Corp.

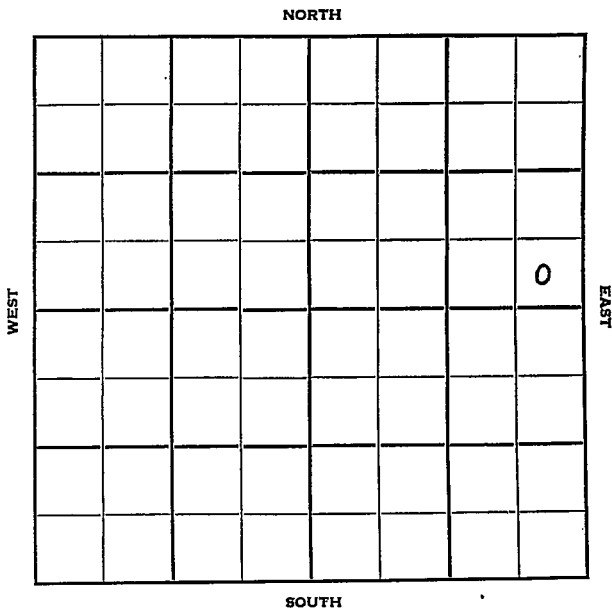

Sec. 20 Twp. 17 R. 11W

Well No. #3 Direen Farm

Sunray Oil Corp. Company

Contractor

Boyle Pool


_____ Ft. from N. Line

330 Ft. from S. Line

330 Ft. from E. Line

_____ Ft. from W. Line

SE SE NE

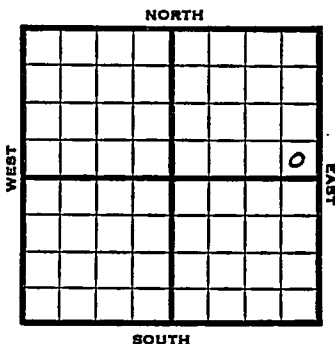

1953

Elev. 1894' REPORT

6/3

Loc.

7/15

Spud 6-11-53
 Oil well TD 3393 13-3/8" @ 123
 8-5/8" @ 874 Lans 3126
 DST 3211-31 open 1 hr rec 105' wtr.
 875# Arb. 3383 TD 3387 5" @ 3384
 Heeb 3054 Br line 3117
 DST 3120-51 open 1/2 hr rec 480' gas,
 60' clean oil, 120' gassy MCO, 30'
 GCM 645# CO to 3387 DD 3393
 3 BOPH 8 hr.
 Comp. 70 BOPD

COMPLETED

