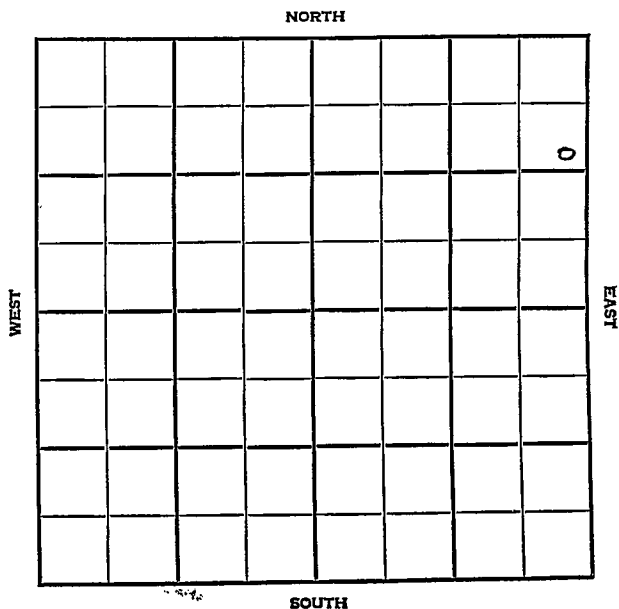


Section 20 Township 17 Range 11WWell No. #2 DirreenCompany Sunray Mid-Continent Oil Co.

Barton

KANSAS

SEC.	TWP.	R.
20	17	14 W

WELL NO.

2 Dirreen

FARM

COMPANY

Sunray Mid-Continent Oil Co.

CONTRACTOR


Carroll

Ft. from N. Line

Ft. from S. Line

Ft. from E. Line

Ft. from W. Line

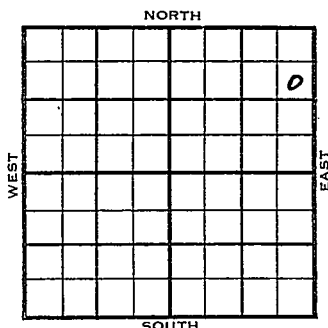

SE NE NE

	ELEVATION	REPORT
1955	1907'	

6/15

DD 3460' 5" @ 3459 /300
 16/3412-16 32/3421-29 300 A
 12 BWPH SP 3300' 32/3146-54
 16/3154-58 16/3158-62 2 BWPH
 PB 3149 dry 36/3143-49 1500 A
 22 BWPH 1/4 hr.

D & A

Anhy 873', H. 3070', BL. 3135',
 L. 3143' Ce. 3369', A. 3411'
 TD 3429' D & A

FIRST REPORT

↓
 ABANDONED

County Barton Elev. 1907
 Sec. 20 Twp. 19 Rge. 14W
 Company Sunray Mid-Continent Oil Co.
 Farm Name Dirreen No. 2

TOPS	DEPTH	LOG	DATUM	Loc. in Sec.
Anh.	873			SE NE NE
TP.				
H.	3070			
Tr.				
Dg.				
BL.	3135			
L.	3143			
K.C.				Geol.
B.K.C.				Contr.
Ce.				
C.	3369			
M.				Pool
M.				Carroll
K.				
Mz.				
Me.				
V.				
S.				
S.				
A.	3411			
R.				
Pe.				
G.				
T.D.	3429			

FIRST REPORT
 JUN 15 '55
 ABANDONED

Date Comm.

DD 3460 5" @ 3459/300 16/ 3412-16

32/ 3421-29 300 A 12 bwph SP 3300

32/ 3146-54 16/ 3154-58 16/ 3158-62

2 bwph PB 3149 dry 36/ 3143-49

1500 A 22 bwph 4 hr.

D & A