
KANSAS Barton

FORM 51 5M PETROL

Section 21 Township 17 Range 14W

Well No. 2 Carroll

Company Yellow Cab

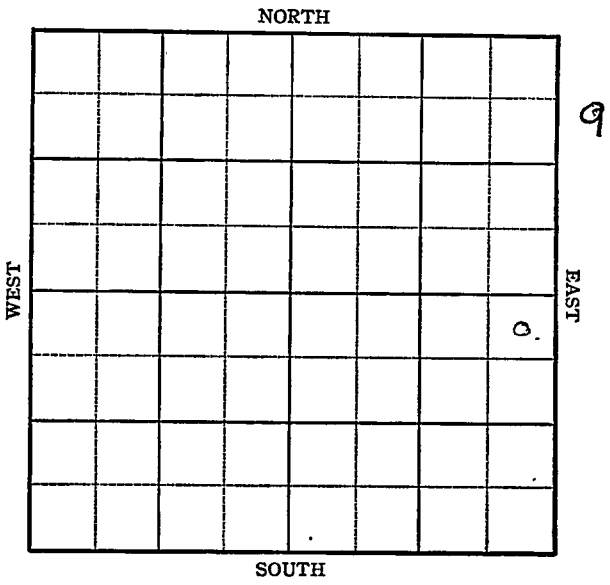

FORM 252-A
5M 8-45 PETROL

KANSAS Barton

Sec. 21 Twp. 17 R. 14-W

Well No. #2 Carroll Farm

Yellow Cab Company


330 Ft. from N. Line

Ft. from S. Line

330 Ft. from E. Line

Ft. from W. Line

NE SE

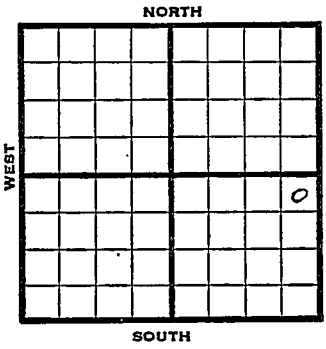

1945	Elev. 1875' REPORT
11/14	RUR
11/21	" " "
11/28	Anhy. 830 8" @ 838 Drlg. 1725
12/5	Drlg. 2855
12/12	Drlg. 3205'
12/20	Lans. 3104' Arb. 3337-43' T.D. 5" - 3341' RUST.
12/29	T.D. 3350' SSO.
1946	
1/10	1000 acid. 1500' oil 9 hours.
1/17	" " "
1/24	" " "
1/31	" " "
2/7	" " "
2/14	" " "
2/21	" " "
2/27	Arb. 3337 5" @ 3341 1000 acid. TD 3350' Pump 207 Pot. Grav. 37.0

COMPLETED

FORM 26 200 BKS 1-44 PETROL

KANSAS Kansas Pool Name Carroll

Map No. 73 Sec. 21 Twp. 17 R. 14W


Well No. 2 Carroll

Yellow Cab Company

FIRST REPORT Contractor

NE SE

SECTION PLAT

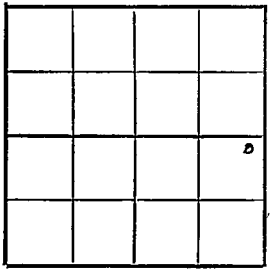

330 Ft. from N. Line

Ft. from S. Line

330 Ft. from E. Line

Ft. from W. Line

Barton County

Location

Rig up

Drilling and Remarks:
RUR

RECORD

Cased in., ft.

Sand

Gas

Oil

Total Depth

PRODUCTION

1st 24 hrs. Nat.

1st 24 hrs. after shot

Gas Cu. Ft.

Dry Hole

Abandoned

Date

NOV 14 1945 19

S. J. LEWIS Scout

FORM 26 200 BKS 1-44 PETROL

Kansas Pool Name Carroll

Map No. 23 Sec. 21 Twp. 17 R. 14W

Well No. 2 Carroll


Yellow Cab Company

COMPLETED Contractor

NE SE

E 1/2 NE

SECTION PLAT

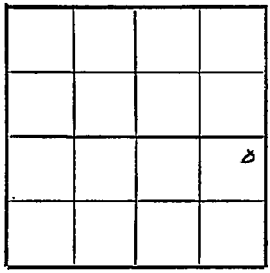

330 Ft. from N. Line

Ft. from S. Line

330 Ft. from E. Line

Ft. from W. Line

Barton County

Location

Rig up

Drilling and Remarks:

Cer #3337

5" @ 3341

1000 acid

Pump 207 B+X

37 Gr

RECORD

Cased in., ft.

Sand

Gas

Oil

Total Depth 3350

PRODUCTION

1st 24 hrs. Nat.

1st 24 hrs. after shot

Gas Cu. Ft.

Dry Hole

Abandoned

Date

FEB 27 1946 19

S. J. LEWIS Scout