

Section 32 Township 32 Range 4E

Well No. #4 Stayton

Company K. T. Weideman

NORTH

0							

WEST

EAST

SOUTH

Cowley

KANSAS

Sec. 32 Twp. 32 R. 4 E

Well No. # 4 Stayton Farm

K. T. Weideman Company

- Contractor


990 Ft. from N. Line

Ft. from S. Line

Ft. from E. Line

330 Ft. from W. Line

SW NW NW

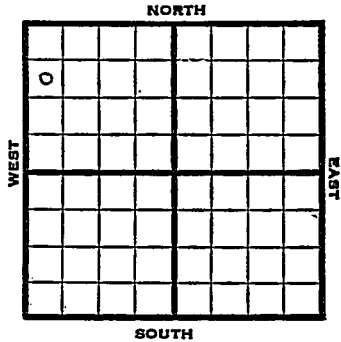

1951 Elev. 1157' REPORT

6/20 Spud 6-18-51
Drilling

8/8 Spud 6-18-51
Oil well TD 3123' 8" @ 126'
Layton 2460' KC 2640-2750'
Bart 3094' 5" @ 3097' TD 3123'
Comp. 20 BOPD

COMPLETED

County Cowley State Kansas

Sec. 32 (Blk. 32) (Sur. 4E) Map No. _____
 (Twp.)

Operator K. T. Weideman

Well No. 4 Farm Stayton

Elev. _____ Location SW NW NW

0							
FIRST REPORT							

990 Ft. From N Line NW
 330 Ft. From W Line Quarter

Ist. Report JUN 20 1951

Completion _____

Remarks _____

Spudding Date 6-18-51

Drig. Data _____

Drig. _____

County Cowley State Kansas

Sec. 32 (Blk. 32 (Sur. 4E (Twp. 32 (Rge. 4E Map No.

Operator K. T. Weidemann

Well No. 4 Farm Stayton

Elev. 1157 Location SW NW NW

o					

COMPLETE

990 Ft. From N Line NW
 330 Ft. From W Line Quarter

Ist. Report _____

Completion AUG 8 1951

Remarks _____

Spudding Date 6-18-51

Drig. Data Oil well 1 TD 3123

8" @ 126 Layton 2460- KC 2640-2750

Bart. 3094 5" @ 3097 TD 3123

Comp. 20 bopd

J. E. TYRA