
FORM 51 25M 8-50 WESTERN KANSAS Cowley

Section ~~31~~ 32 Township 32 Range 4-E

Well No. #2 Stayton

Company K T Weidemann

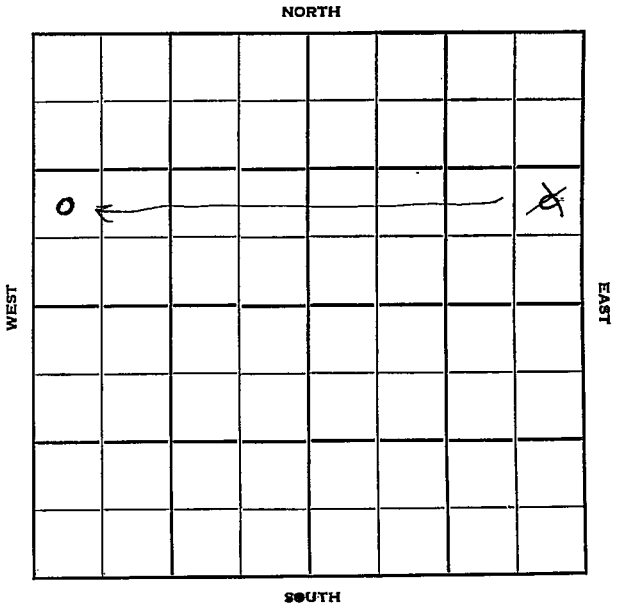

FORM 252-B
10M 10-50 PETROL


Cowley KANSAS

Sec. ~~31~~ 32 Twp. 32 R. ~~V~~ 4E

Well No. #2 Stayton Farm

K. T. Weidemann Company

Contractor

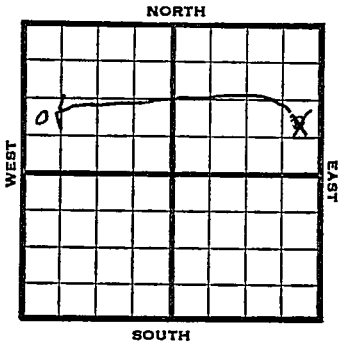

Ft. from N. Line

990' Ft. from S. Line

~~330'~~ Ft. from E. Line

330 Ft. from W. Line

~~NE SE NE~~
NW SW NW

1950	Elev. 1157' REPORT
12/27	Location
1951	
5/16	Spud 12-27-50 Oil Well TD 3133 8" @ 118 Layton 2470 KC 2647 BKC 2740 Cherokee 2951 Bart 3089-91 5" @ 3091 TD 3133 Hydrafrac F/50 bopd Comp. 25 bo 25 bwpd COMPLETED

FORM 275 FOR SALE BY KANSAS BLUE PRINT CO.


County Cowley State Kansas

Sec. 31 (Blk. Twp.) 32 (Sur. Rge.) 4E Map No.

Operator K. T. Weidemann

Well No. 2 Farm Stayton

Elev. Location NE SE NE

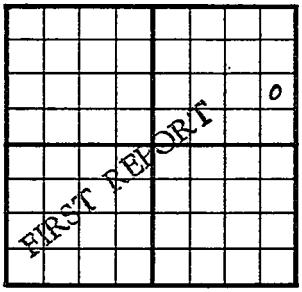

990 Ft. From S Line NE

330 Ft. From E Line Quarter

1st. Report DEC 27 1950

Completion

Remarks

Spudding Date

Drlg. Data Stayton Pool

Location

J. E. TYRA

Form 26 200 Bks. 11-49 Petrol

Kansas

Map No. _____ Sec. 32 Twp. 32 R. 4E


Well No. 2 Stayton

K. T. Weidemann Company

CORRECTION Contractor

NW SW NW

SECTION PLAT

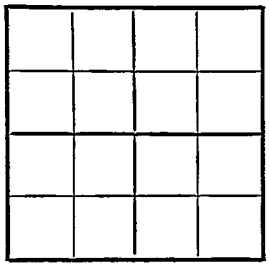

_____ Ft. from N. Line

990 Ft. from S. Line

_____ Ft. from E. Line

330 Ft. from W. Line

Cowley County

Location _____

Rig up _____

Drilling and Remarks:

Reported

NE SE NE

31-32-4E

RECORD

Cased _____ in., _____ ft.

Sand _____

Gas _____

Oil _____

Total Depth _____

PRODUCTION

1st 24 hrs. Nat. _____

1st 24 hrs. after shot _____

Gas _____ Cu. Ft.

Dry Hole _____

Abandoned _____

Date

JAN 10 1951 19 _____

J. E. TYRA Scout

FORM 275 FOR SALE BY KANSAS BLUE PRINT CO.


County Cowley State Kansas

Sec. 32 (Blk. Twp.) 32 (Sur. Rge.) 4E Map No.

Operator K. T. Weidemann

Well No. 2 Farm Stayton

Elev. 1157 Location NW SW NW

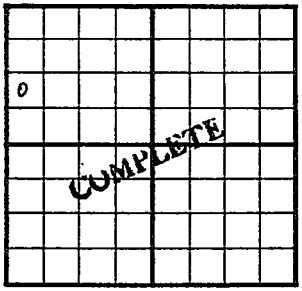

990 Ft. From S Line NW

330 Ft. From W Line Quarter

1st. Report

Completion MAY 16 1951

Remarks Stayton Pool

Spudding Date 12-27-50

Drlg. Data Oil well TD 3133

8" @ 118 Layton 2470 KC 2647

B KC 2740 Cherokee 2951 Bart. 3089-91

5" @ 3091 TD 3133 Hydrofrac F/ 50 bopd

Comp. 25 bo 25 bwpd

J. E. TYRA