
DX 78-1 Barton **KANSAS**

Section 21 Township 17 Range 14W

Well No. #9 Connor

Company Sunray Mid-Continent Oil Co.

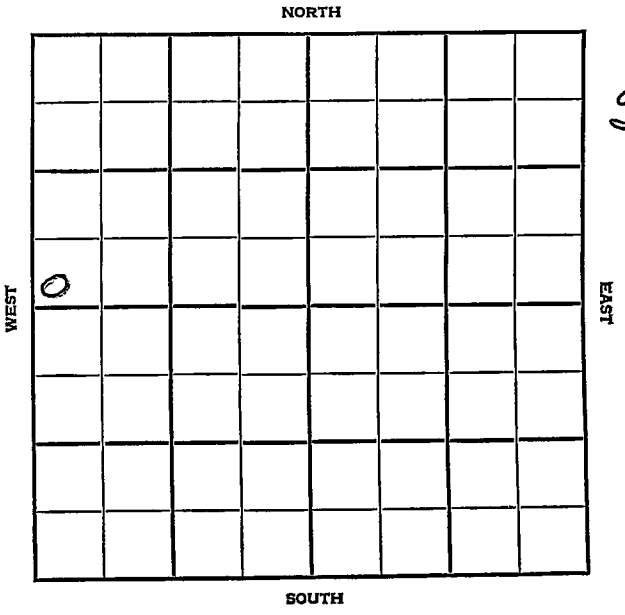

HOT FILE

Barton KANSAS

SEC.	TWP.	R.
21	17	14 W


WELL NO.

9 Connor FARM

COMPANY

Sunray Mid-Continent Oil Co.

CONTRACTOR

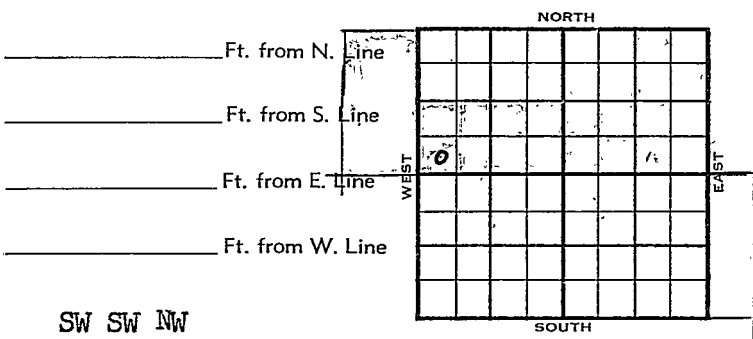

SW SW NW

Development well

1955	ELEVATION REPORT
5/15	Location
5/19	" Digging cellar & pits (DR-99)
5/20	" RURT (DR-100)
5/23	TD 880'. WOC 8-5/8" @ 878' Spud 5-20-55 (DR-101)
5/24	Drlg. 1630' (DR-102)
5/25	Drlg. 2115' (DR-103)
5/31	TD 3408' Heeb 3055, Tor 3070, Br Li 3122 5½" csg @ 3394' w/150 WOCT KC 3133, Arb. 3392' DST #1 3146'-62' tool open 1' Rec 30' Muddy water BHFP 25# BHP 660# (DR106)
6/3	Prep to Acidize T.D. 3408
6/6	Acidized - Tested 6 hrs. made 180 bbls oil and 72 bbls water per day Prep. to put on pump
6/7	T.D. 3408 Running rods & tubing
6/8	Waiting on pumping unit
6/9	" " "
6/10	3408 WOP unit
6/13	TD 3408' Waiting on pump unit. (#115)
6/14	TD 3408' Waiting on pump unit.

OVER

DX-78

6/16 3408' waiting on pump unit

6/16 P 14' @ 103 BO/d rate

6/20 P 12' @ 80BO/d rate

6/23 P/60 BO, NW, in 14 hrs.

6/29 Comm. 5-20-55
8 5/8", @ 878/600 DST 3146-62 op 1 hr. Rec. 30' mw 660/30" 5½@3344/150 CO to 3408 PB 3405 500A 180 bo 72bw 6 hr. Comp. 25 bopd.

Tops:	Depth	Log	Datum
Anh.	870	870	
H.	3055	3056	1154
Tr.	3070	3066	1164
BL.	3122	3122	1220
KC	3133	3133	1231
BKC		3349	1447
A.	3392	3393	1491
TD.	3408		

COMPLETED

Twp. Pool

Co. Facet

FORM 513 REV. SUNRAY

FIRST REPORT

County Barton Elev.

Sec. 21 Twp. 17 Rge. 14W

Company Sunray Mid-Continent Oil Co.

Farm Name Connor No. 9

TOPS	DEPTH	LOG	DATUM
Anh.			
T.P.			
H.			
Tr.			
Dg.			
Bl.			
L.			
K.C.			
B.K.C.			
Ce.			
C.			
M.			
M.			
K.			
Mz.			
Mc.			
V.			
S.			
S.			
A			
R.			
P€.			
G.			
T.D.			

Loc. in Sec.

SW SW NW

Geol.

Contr.

Pool

Date Comm.

Location

Co. Lse. No. Sec. T. R.

FORM 513 REV. SUNRAY

County Barton Elev. 1899 DF 1902 KB

Sec. 21 Twp. 17 Rge. 14W

Company Sunray Mid-Continent Oil Co.

Farm Name Connor No. 9

TOPS	DEPTH	LOG	DATUM
Anh.	870	870	
T.P.			
H.	3055	3056	1154
Tr.	3070	3066	1164
Dg.			
Bl.	3122	3122	1220
L.			
K.C.	3133	3133	1231
B.K.C.		3349	1447
Ce.			
C.			
M.			
M.			
K.			
Mz.			
Me.			
V.			
S.			
S.			
A	3392	3393	1491
R.			
P€.	PB		1603
G.			
	5½		1442
T.D.	3408		1506

Loc. in Sec. SW SW NW

Geol.

Contr.

Pool

COMPLETE

Date Comm. 5-20-55 JUN 2 9 1955

8 5/8" @ 878/600 DST 3146-62 open 1 hr

Rec. 30' mw 660/30" 5½" @ 3344/150

CO to 3408 PB 3405 500 A 180 bbo

72 bw 6 hr. P/ 60 bo 14 hr.

Comp. 25 bopd

Co. Lse. No. Sec. T. R.