


KANSAS Barton

FORM 51 5M PETROL

Section 21 Township 17 Range 11W

Well No. 1 Karst

Company Phillips

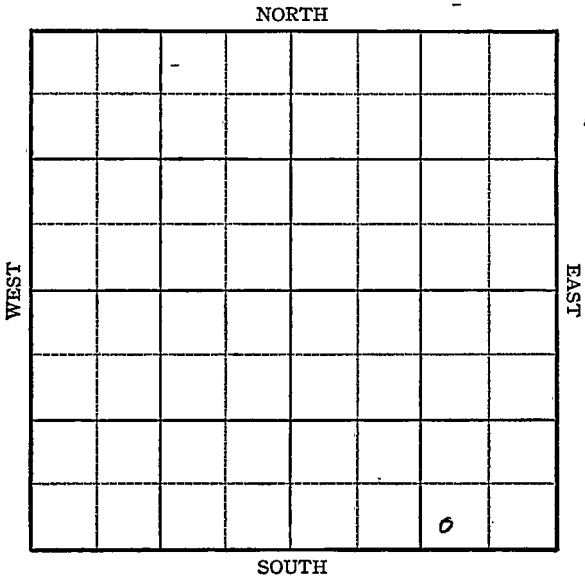

KANSAS


Barton

Sec. 21 Twp. 17 R. 14WWell No. 1 Karst FarmPhillips Company

Carrol

 Ft. from N. Line372 Ft. from S. Line940 Ft. from E. Line Ft. from W. Line

SW SE SE Elev. 1875

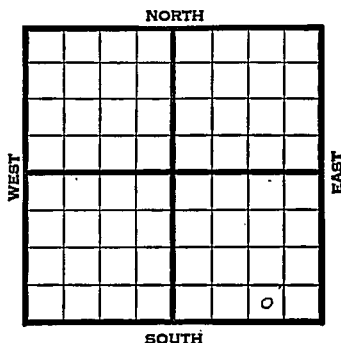

1945

REPORT

6/20	696'
6/28	8" @ 877
	Delg. 2906
7/3	Lans 3103
	Conc 3328
	Arb. 3363-3366
	TD 3366 SSO
	5" @ 3363' RUST
7/11	300 acid.
	Swab 59 oil in 18 hrs.
7/19	" " " " "
7/26	" " " " "
8/8	Arb. 3363
	5" @ 3363'
	T.D. 3366'
	1300 acid
	Pump 244 Pot
	Gravity 39

COMPLETED


Kans^{as} Pool Name CarrolMap No. 73 Sec. 21 Twp. 17 R. 14WWell No. 1 KarstPhillips Company

FIRST REPORT

Contractor

SW SE SE

SECTION PLAT

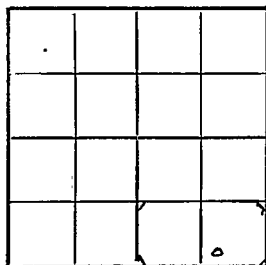 Ft. from N. Line372 Ft. from S. Line940 Ft. from E. Line Ft. from W. LineBarton CountyLocation Rig up

Drilling and Remarks:

696

RECORD

Cased in., ft.Sand Gas Oil Total Depth

PRODUCTION

1st 24 hrs. Nat. 1st 24 hrs. after shot Gas Cu. Ft.Dry Hole Abandoned

Date

JUN 20 1945

19

S. J. LEWIS

Scout

KANSAS


Kansas

Pool Name CarrolMap No. 73 Sec. 21 Twp. 17 R. 14WWell No. 1 KarstPhillips Company

COMPLETED

Contractor

SW SE SE

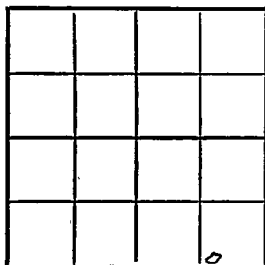E1185
SECTION PLATFt. from N. Line372 Ft. from S. Line940 Ft. from E. LineFt. from W. Line

Barton County

Location

Rig up

Drilling and Remarks:

Ar 33635" @ 33631300 acidPump 244 BX39° 5'

RECORD

Cased _____ in., _____ ft.

Sand _____

Gas _____

Oil _____

Total Depth 3366

PRODUCTION

1st 24 hrs. Nat. _____

1st 24 hrs. after shot _____

Gas _____ Cu. Ft.

Dry Hole _____

Abandoned _____

Date

AUG 8 1945 19

S. J. LEWIS Scout