

Map No. Kans Sec. 25 Twp. 32 R. 4


Well No. 4 Mc Fadden Farm
J. F. Darby Company

660 Ft. from N. Line

..... Ft. from S. Line

..... Ft. from E. Line

1120 Ft. from W. Line

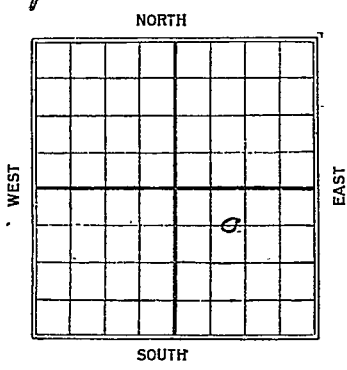

Date
1925

REPORT

1/24 Sand 1488-99 T.D. 1505
 15 gts 20 Bbls oil
 100 Bbls water

Map No. 2 **KANSAS** Sec. 25 Twp. 32 R. 4

Well No. 4-m^c7 adden

J. F. Larby Company

FIRST REPORT

Contractor

COMPLETED

SECTION PLAT

660 Ft. from N. Line

_____ Ft. from S. Line

_____ Ft. from E. Line

1120 Ft. from W. Line

		●	

Location _____

Rig up _____

Drilling and Remarks:

1488-99

20.1505

15/20 lbs oil
100 lbs water

RECORD

Cased _____ in., _____ ft.

Sand _____

Gas _____

Oil _____

Total Depth _____

PRODUCTION

1st 24 hrs. Nat. _____

1st 24 hrs. after shot _____

Gas _____ Cu. Ft.

Dry Hole _____

Abandoned _____

Date

1/24

1925

M. A. BENEAR

Scout