


Map No. Kansas Sec. 25 Twp. 32 R. 4

Well No. 5 Mc Fadden Farm
Rathvan etal Company

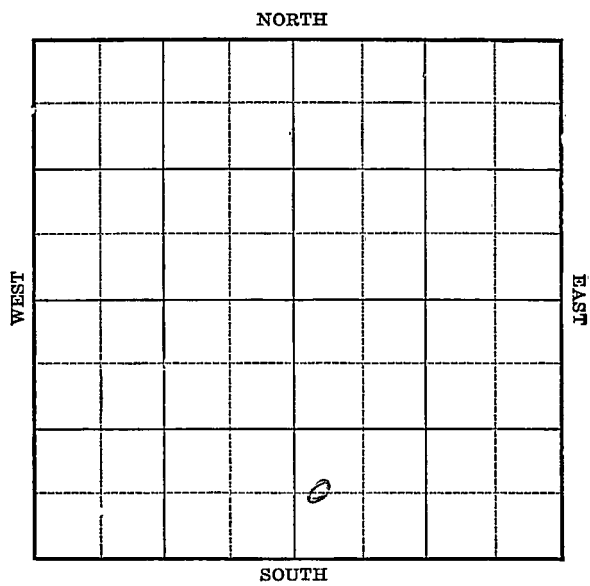

Location _____

Drilling Remarks _____

Rig Up _____

Drilling Remarks _____

RECORD

Cased _____ in. _____ ft.

Sand _____

Gas _____

Oil _____

Total Depth _____

PRODUCTION

1st 24 hrs. Nat. _____

1st. 24 hrs. after shot _____

Gas _____ cu. ft.

Dry Hole _____

Abandoned _____

Map No. Kans Sec. 25 Twp. 32 R. 4


Well No. 5 Mc Fadden Farm
Rathran et al Company

_____ Ft. from N. Line

660 Ft. from S. Line

_____ Ft. from E. Line

200 Ft. from W. Line

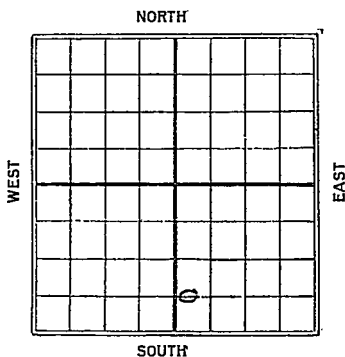

Date
1925

REPORT

1/24 Sand 1463-69 T.D.
 20 gals 75 Bbl Oil
 10 Bbl Water

Map No. 2 **KANSAS** Sec. 25 Twp. 32 R. 4

Well No. 5 m^c Fadden

Rathnow et al Company

FIRST REPORT

Contractor

COMPLETED SECTION PLAT

----- Ft. from N. Line

660 Ft. from S. Line

----- Ft. from E. Line

300 Ft. from W. Line

		●	

Location -----

Rig up -----

Drilling and Remarks:

sand 1463-69
T.D. 1469

20/75 lbs oil
10 lbs water

RECORD

Cased ----- in., ----- ft.

Sand -----

Gas -----

Oil -----

Total Depth -----

PRODUCTION

1st 24 hrs. Nat. -----

1st 24 hrs. after shot -----

Gas ----- Cu. Ft.

Dry Hole -----

Abandoned -----

Date

1/24 1925

M. A. BENEAR

Scout