


Section 35 Township 32 Range 4E

Well No. #1 Harris

Company L.C. Smitherman et al

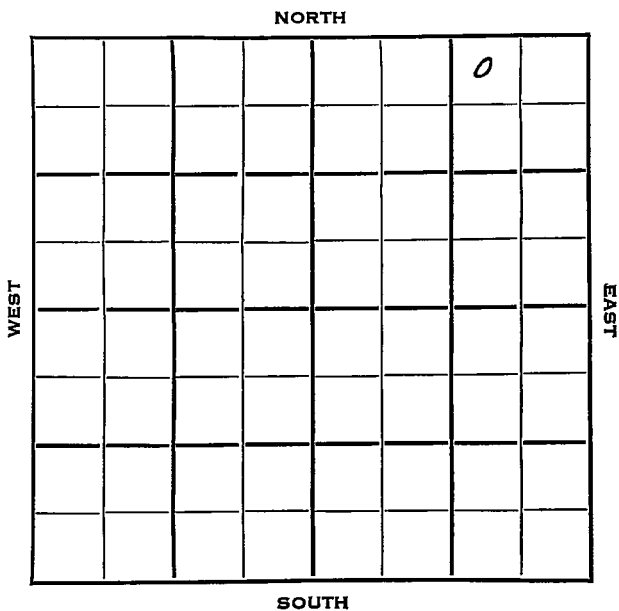

Cowley

KANSAS

|            |            |            |
|------------|------------|------------|
| SEC.<br>35 | TWP.<br>32 | R.<br>4E ✓ |
|------------|------------|------------|

WELL NO. #1 Harris FARM

COMPANY L.C. Smitherman et al

CONTRACTOR


Winfield Pool

330 Ft. from N. Line

Ft. from S. Line

990 Ft. from E. Line

Ft. from W. Line

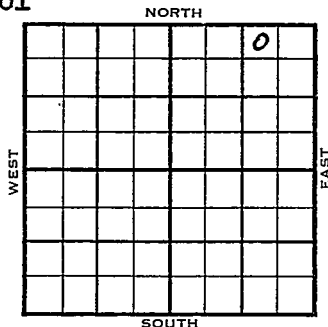

NW NE NE

|      |                    |        |
|------|--------------------|--------|
| 1954 | ELEVATION<br>1201' | REPORT |
|------|--------------------|--------|

2/3 Surface Set  
 3/10 Spud 2-20-54  
 Oil Well  
 TD 2927'  
 8" @ 140'  
 Hoover 1790', Stal. 1915', Layton  
 2343', KC 2520', Bart 2911'  
 TD 2918'  
 5" @ 2913'  
 DD 2927' Hydro. F/ 100 bo 1 hr.  
 Comp F. 25 bopd.

**COMPLETED**



