


Map No. Kansas Sec. 36 Twp. 32 R. 4

Well No. 4 Keithley Farm
Emerald Company

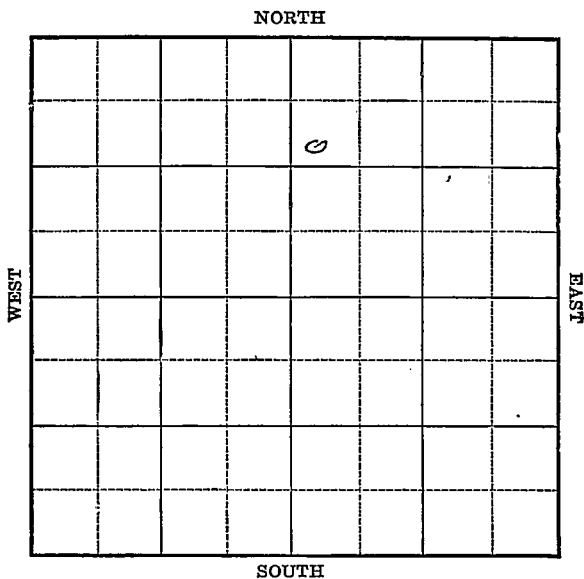

Location _____

Drilling Remarks _____

Rig Up _____

Drilling Remarks _____

RECORD

Cased _____ in. _____ ft.

Sand _____

Gas _____

Oil _____

Total Depth _____

PRODUCTION

1st 24 hrs. Nat. _____

1st. 24 hrs. after shot _____

Gas _____ cu. ft.

Dry Hole _____

Abandoned _____

Map No. Kans Sec. 36 Twp. 32 R. 4


Well No. 4 Keithley Farm
Emerald Company

1120 Ft. from N. Line

..... Ft. from S. Line

..... Ft. from E. Line

200 Ft. from W. Line

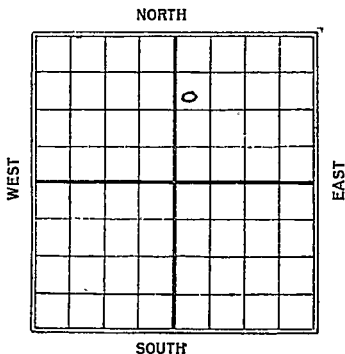

Date
1925

REPORT

1/24 S. + Q. 1750'

Map No. 2 **KANSAS** Sec. 36 Twp. 32 R. 4

Well No. 4 Keithley

Emerald Company

FIRST REPORT Contractor

ABANDONED SECTION PLAT

1120 Ft. from N. Line

_____ Ft. from S. Line

_____ Ft. from E. Line

300 Ft. from W. Line

		7	

Location _____

Rig up _____

Drilling and Remarks:

10 x 9
1750'

RECORD

Cased _____ in., _____ ft.

Sand _____

Gas _____

Oil _____

Total Depth _____

PRODUCTION

1st 24 hrs. Nat. _____

1st 24 hrs. after shot _____

Gas _____ Cu. Ft.

Dry Hole _____

Abandoned _____

Date

1/24

1925

M. A. BENEAR

Scout

Cowley
K2
MAP NO. KANSAS SEC. 36 TWP. 32S R. 1E

WELL NO. 1 Keithley
Bufflo Inds COMPANY

CONTRACTOR

SECTION PLAT

ABANDONED

		0	

_____ FT. FROM N. LINE
 _____ FT. FROM S. LINE
 _____ FT. FROM E. LINE
 _____ FT. FROM W. LINE

LOCATION _____

RIG UP _____

DRILLING AND REMARKS:

[Handwritten squiggle]

RECORD

CASED _____ IN., _____ FT.
 SAND _____
 GAS _____
 OIL _____
 TOTAL DEPTH 1750

PRODUCTION

1ST 24 HRS. NAT. _____
 1ST 24 HRS. AFTER SHOT _____
 GAS _____ CU. FT.
 DRY HOLE
 ABANDONED

DATE

4/2 4

192

SCOUT