

Map No. Kans Sec. 36 Twp. 22 R. 4


Well No. 2 Keithley Farm
Emerald Company

_____ Ft. from N. Line

1120 Ft. from S. Line

_____ Ft. from E. Line

200 Ft. from W. Line

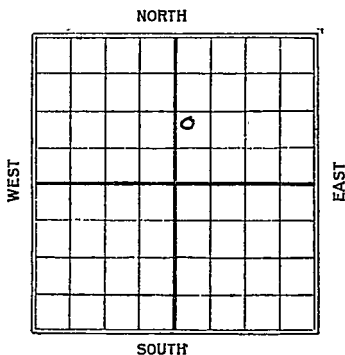

Date

REPORT

1925

1/24 1437-52 7 gals 80 Bbls oil
70 Bbls Water

Map No. 2 ~~KANSAS~~ Sec. 36 Twp. 32 R. 4

Well No. 2 Keithley
Emerald Company

FIRST REPORT Contractor

COMPLETED

SECTION PLAT

----- Ft. from N. Line

1120 Ft. from S. Line

----- Ft. from E. Line

200 Ft. from W. Line

| | | | |
|--|--|---|--|
| | | | |
| | | o | |
| | | | |
| | | | |

Location -----

Rig up -----

Drilling and Remarks: ,

1437-52

7/80 oil
70 water.

RECORD

Cased ----- in., ----- ft.

Sand -----

Gas -----

Oil -----

Total Depth -----

PRODUCTION

1st 24 hrs. Nat. -----

1st 24 hrs. after shot -----

Gas ----- Cu. Ft.

Dry Hole -----

Abandoned -----

Date

1/24

1925

M. A. BENEAR

Scout