


Map No. Kansas Sec. 36 Twp. 32 R. 4

Well No. 1 Miller Farm
Smith Bros Company

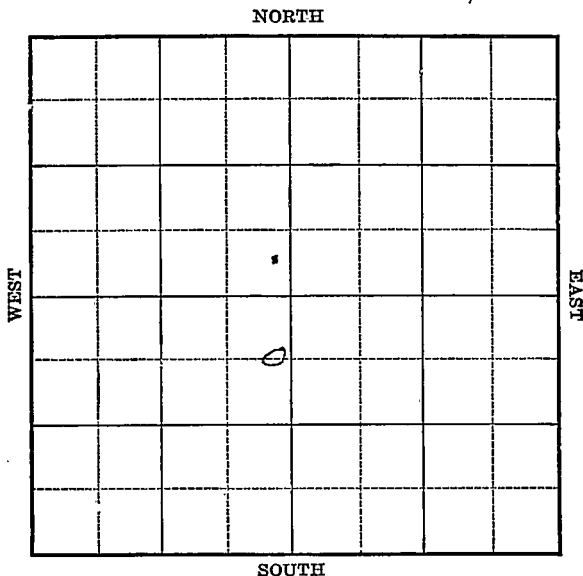

Location _____
Drilling Remarks _____

Rig Up _____
Drilling Remarks _____

RECORD

Cased _____ in. _____ ft.
Sand _____
Gas _____
Oil _____
Total Depth _____

PRODUCTION

1st 24 hrs. Nat. _____
1st. 24 hrs. after shot _____
Gas _____ cu. ft.
Dry Hole _____
Abandoned _____

Map No. 2 **KANSAS** Sec. 36 Twp. 32 R. 4

Well No. 1 Miller

Smith Bros Company

FIRST REPORT

Contractor

COMPLETED

SECTION PLAT

	*		

660 Ft. from N. Line

_____ Ft. from S. Line

200 Ft. from E. Line

_____ Ft. from W. Line

Location _____

Rig up _____

Drilling and Remarks:

Gas s. 658-72'

1/2 mil gas

RECORD

Cased _____ in., _____ ft.

Sand _____

Gas _____

Oil _____

Total Depth _____

PRODUCTION

1st 24 hrs. Nat. _____

1st 24 hrs. after shot _____

Gas _____ Cu. Ft.

Dry Hole _____

Abandoned _____

Date

1/24

1925

M. A. BENEAR

Scout