


Section 26 Township 32 Range 4E

Well No. 1 Goode

Company Kriswell & Associates

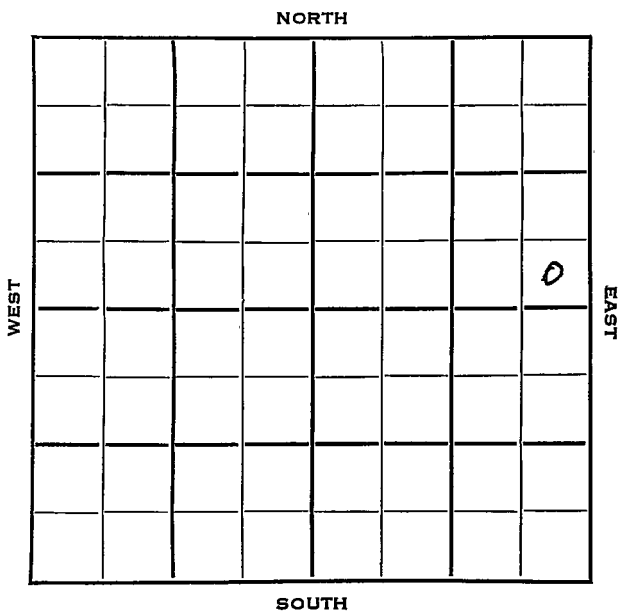

Cowley

KANSAS

SEC.	TWP.	R.
26	32	4 E



WELL NO.

1 Goode

FARM

COMPANY

Kriswell & Associates

CONTRACTOR

H. H. Blair


_____ Ft. from N. Line

330 _____ Ft. from S. Line

330 _____ Ft. from E. Line

_____ Ft. from W. Line

SE SE NE

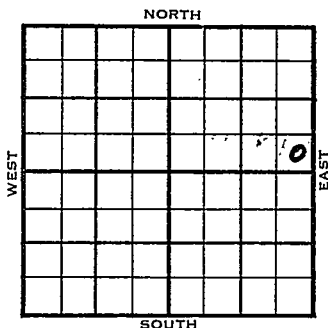

1953

ELEVATION

1207'

REPORT

10/21

Spud 10-16-53

8" @ 126

Drlg. 1560'

11/24

Spud 10-16-53

Oil Well

TD 3077'

8" @ 126'

Peacock 1452', Hoover 1740', Stal.

1918', Layton 2359', KC 2517',

Cherokee 2825', Bart. 2936', Miss

3055'

TD 3077'

5" @ 3077'

20/2939-59, 2 go SI 12 hrs.

FU 150' oil

SP 2920

Sd-oil-frac

F/4 boph

Comp. 25 bopd

COMPLETED

County Cowley State Kansas
Butler

Sec. 26 (Blk. (Twp.)) 32 (Sur. Rge.) 4E Map No.

Operator Kriswell & Associates

Well No. 1 Farm Goode

Elev. _____ Location SE SE NE

330 Ft. From S Line NE

330 Ft. From E Line Quarter

1st. Report OCT 21 1953

Completion _____

Remarks _____

H.H. Blair - Contr.

Spudding Date 10-16-53

Drlg. Data _____

8" @ 126 drlg. 1560

Hey Joe,

You gave us the wrong ϕ . County
or township, I don't know which. Please
check both.....

Scout Cards	7777
Land Small Map	
Land Wall Map	5
Tracings	
France Map	
Pierce Map	
Misc.	

OCT 23 1953

Orig. Date

County Cowley State Kansas

Sec. 26 (Blk. 32) (Sur. 4E) (Twp. 4E) Map No.

Operator Kriswell & Associates

Well No. 1 Farm Goode

Elev. 1207 Location SE SE NE

330 Ft. From S Line NE

330 Ft. From E Line Quarter

1st. Report

Completion NOV 24 1953

Remarks

H.H. Blair - Contr.

Spudding Date 10-16-53

Drlg. Data Oil well TD 3077

8" @ 126 Peacock 1452 Hoover 1740

Stal. 1918 Layton 2359 KC 2517

Cherokee 2825 Bart. 2936 Miss. 3055

TD 3077 5" @ 3077 20/ 2939-59

2 go SI 12 hr. FU 150' oil SP 2920

sd-oil-frac F/ 4 boph Comp. 25 bopd

J. G. McGEHEE