

Map No. Kane Sec. 36 Twp. 32 R. 4

Well No. 1 Peacock Farm


W. B. Price Company

..... Ft. from N. Line

1120 Ft. from S. Line

200 Ft. from E. Line

..... Ft. from W. Line

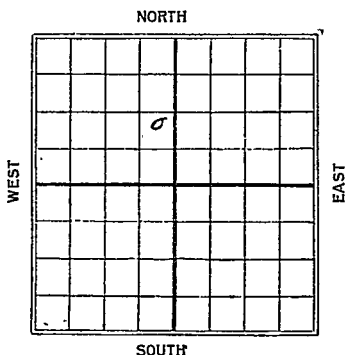

Date

REPORT

1925

1/24

Sand 1484-95

Shot 3-4 + 8 gts

Pumping 110 Bbls

Map No. 2 **KANSAS** Sec. 36 Twp. 32 R. 4

Well No. 1 Peacock

W. B. Price Company

FIRST REPORT

Contractor

COMPLETED

SECTION PLAT

	o		

-----Ft. from N. Line

1120 Ft. from S. Line

200 Ft. from E. Line

-----Ft. from W. Line

Location -----

Rig up -----

Drilling and Remarks:

*0.1484 - 95
shot 3, 4 - 8 qts,
pumping 110 lbs*

RECORD

Cased ----- in., ----- ft.

Sand -----

Gas -----

Oil -----

Total Depth -----

PRODUCTION

1st 24 hrs. Nat. -----

1st 24 hrs. after shot -----

Gas ----- Cu. Ft.

Dry Hole -----

Abandoned -----

Date

1/24

1925

M. A. BENEAR

Scout