

WEST

EAST

SOUTH

Drilling Remarks

Drilling Remarks

PRODUCTION

Total Depth_____

Abandoned _____


Map No. KANSAS Sec. 4 Twp. 16 R. 11 W
 Well No. 1 - Davidson Farm
Prairie Oil & Gas Company

330 Ft. from N. Line

_____ Ft. from S. Line

_____ Ft. from E. Line

330 Ft. from W. Line

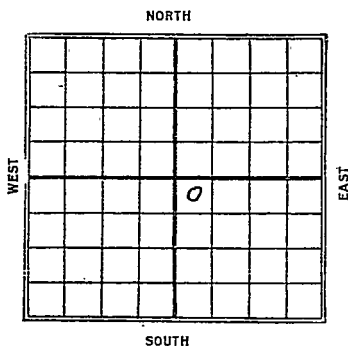

1929

Date	REPORT
10/23	Location
10/30	—
11/6	—
11/13	—
11/20	ROC
11/27	—
12/4	—
12/11	addy Rig
12/18	Rig up
12/23	—
12/30	—
1/30	Drily 300'
1/8	S.L.D. 520'
1/15	—
1/22	U.I.R. 15 1/2" - 525'
1/29	Drily 1315
2/5	Log tools 1975'
2/12	Drily 2315
2/19	2635 - 8" at 2595.
2/26	Ran 6" - 3030
3/5	Drily 3175'
3/12	—

3/19- Only. 3240' show gas.
3/26- Top Gorham sand 3317
Run 5"- 3317
Pay 3332-35'
filled up 700 oil 1st hour
" " 1600 " in 7 1/2 hrs
Grav. 38 at 63°
S.D. storage
3/28- First oil 3332-35'
swabbed 70 bbl
and swab down
drilled to TD. 3340
swab 155 bbl 16 1/2 hr
swabs down
show water
4/2- Sand 3314-40
TD. 3340
swab 210 bbl oil
" 30 " water
Pump.

Map No. KANSAS Sec. 4 Twp. 16 R. 11W

Well No. 55 1 Davidson

Prairie Oil & G. Company

Contractor

SECTION PLAT

330 Ft. from N. Line

_____ Ft. from S. Line

_____ Ft. from E. Line

330 Ft. from W. Line

		0	

FIRST REPORTS

Location ✓

Rig up _____

Drilling and Remarks:

RECORD

Cased _____ in., _____ ft.

Sand _____

Gas _____

Oil _____

Total Depth _____

PRODUCTION

1st 24 hrs. Nat. _____

1st 24 hrs. after shot _____

Gas _____ Cu. Ft.

Dry Hole _____

Abandoned _____

Date

OCT 23 1925

S. J. LEWIS Scout

Map No. **KANSAS** Sec. **4** Twp. **16** R. **11W**
 SS
 Well No. **1 Davidson**

Prairie O & G Company

Contractor

SECTION PLAT

330 Ft. from N. Line

Ft. from S. Line

Ft. from E. Line

330 Ft. from W. Line

		o	

COMPLETED

Location

Rig up

Drilling and Remarks:

Swath 210 yds oil

" 30" water

RECORD

Cased in., ft.

Sand **3314-40**

Gas

Oil

Total Depth **3340**

PRODUCTION

1st 24 hrs. Nat.

1st 24 hrs. after shot

Gas Cu. Ft.

Dry Hole

Abandoned

Date

APR 2 - 1930

192

S. J. LEWIS

Scout