

KANSAS


Form 51—5M—7-40—Palace

Barton

Section 4 Township 16 Range 11-W

Well No. 1 Peirano

Company H. H. Blair

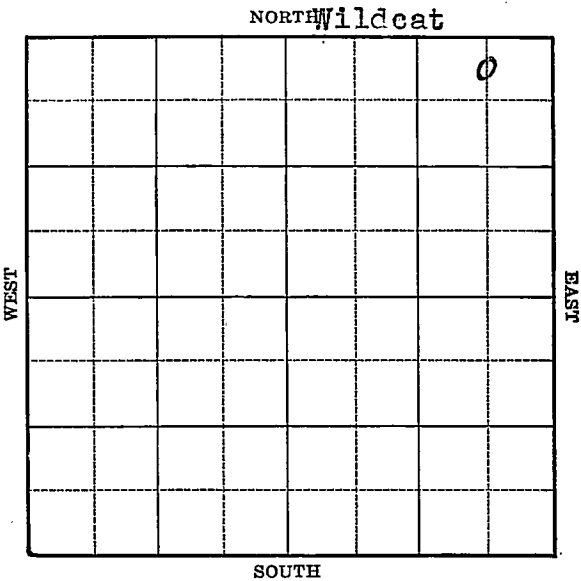

KANSAS

Barton

Sec. 4 Twp. 16 R. 11-WWell No. #1 Peirano FarmH. H. Blair Company

(Wildcat)


330 Ft. from N. Line

Ft. from S. Line

660 Ft. from E. Line

Ft. from W. Line

Elev. 1814

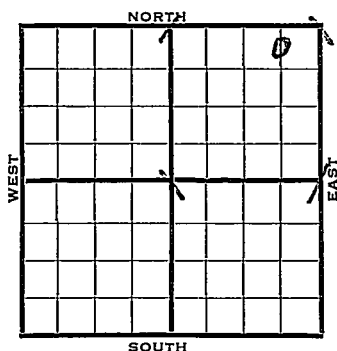

1941	REPORT
1/29	Location
2/6	"
2/13	"
2/20	"
2/27	"
3/6	Cable rig.
3/13	" "
3/20	12" - 270'
	Drlg. 440'
3/27	Anhy 665' 10" - 715'
	Drlg. 1080'
4/2	8" - 1960' Drlg. 1965'
4/10	2325' U.R. 8".
4/18	8" - 2419' Topeka 2575'
	Show gas 2580-90' Dlg. 2780'
4/24	Lans. 2930' Pay 3018-20' T.D.
	7" - 3011' WOC. S.O.
5/1	4000 acid. Pump 48 bbls.
	Shut down.
5/8	1000 acid. Flow 40 bbls.
	Shut down.

OVER

1941

5/14

Lans. 2930'

7" - 3011'

T.D. 3020'

1000 acid.

Potential 500 bbls., flow.

40.9 Gravity

COMPLETED

Map No. 53 Sec. 4 Twp. 16 R. 11WWell No. 1 PeiranoH. H. Blair


Company

FIRST REPORT

Contractor

SECTION PLAT

C N L NE NE

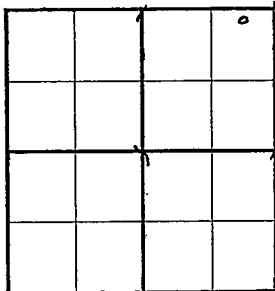330 Ft. from N. Line Ft. from S. Line660 Ft. from E. Line Ft. from W. Line

WILDCAT

Location XRig up

Drilling and Remarks:

RECORDCased in., ft.Sand Gas Oil Total Depth **PRODUCTION**1st 24 hrs.-Nat. 1st 24 hrs. after shot Gas Cu. Ft.Dry Hole Abandoned

Date

JAN 29 1941 19S. J. LEWIS

Scout

Map No. 55 Sec. 4 Twp. 16 R. 11WWell No. 1 PeiranoH. H. Blair

Company

Contractor

COMPLETED

SECTION PLAT

C N L NE NE

330 Ft. from N. Line Ft. from S. Line660 Ft. from E. Line Ft. from W. Line

WIID CAT

			0

Location Rig up

Drilling and Remarks:

Lans 29907" @ 80111000 acidFlow 500 Psd.40⁹ Gr.

RECORD

Cased in., ft.Sand Gas Oil Total Depth 3020

PRODUCTION

1st 24 hrs. Nat. 1st 24 hrs. after shot Gas Cu. Ft.Dry Hole Abandoned

Date

MAY 14 1941

19

S. J. LEWIS Scout