

Section 5 Township 16 Range 11WWell No. #1 ThillCompany Brunson Dr.g. & NCRA

NORTH

0							

SOUTH

WEST

EAST

Barton

KANSAS

Sec. 5 Twp. 16 R. 11W

Well No. #1 Thill Farm ☒

Brunson Drlg. & NCRA Company

Brunson Drlg. - Contr. Contractor
Wildcat

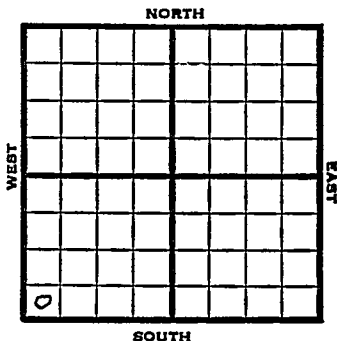
 Ft. from N. Line

330' Ft. from S. Line

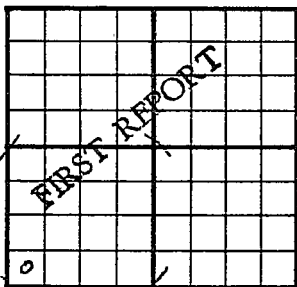
 Ft. from E. Line

330' Ft. from W. Line

SW SW SW



1951	Elev. 1802'	REPORT
3/21	Spud 3-14-51 8" @ 290' Anhy 672 Drlg. 1986'	
3/28	Spud 3-14-51 D & A TD 3310' 8" @ 290 Anhy 672' Heeb 2864' Toronto 2881' Douglas 2891' Br. line 2954' Lans. 2972' Cong. 3269' TD 3310' D & A	
ABANDONED		

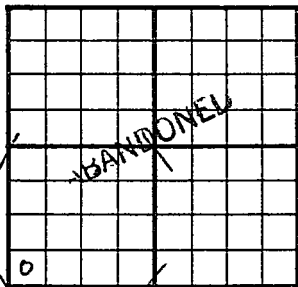
County Barton State KansasSec. 5 (Blk.
Twp.) 16 (Sur.
Rge.) 11W Map No.Operator Brunson Drlg. & NCRAWell No. 1 Farm ThillElev. 1802 Location SW SW SW330 Ft. From S Line SW330 Ft. From W Line Quarter1st. Report MAR 21 1951

Completion

Remarks

Brunson Drlg. - Contr.Spudding Date 3-14-51Drlg. Data Wildcat8" @ 290 Anhy 672 drlg. 1986

J. E. TYRA

County Barton State KansasSec. 5 (Blk.
Twp.) 16 (Sur.
Rge.) 11W Map No.Operator Brunson Drlg. & NCRAWell No. 1 Farm ThillElev. 1802 Location *SW SW SW330 Ft. From S Line SW330 Ft. From W Line Quarter1st. ReportCompletion MAR 28 1951Remarks WildcatBrunson Drlg. - Contr.Spudding Date 3-14-51Drlg. Data D & A TD 33108" @ 290 Anhy 672 Heeb. 2864Toronto 2881 Douglas 2891 Br. lime 2954Lans. 2972 Cong. 3269 TD 3310D & A

J. E. TYRA