


Map No. 7 Sec. 5 Twp. 32 R. 5

Well No. 1 Logan Farm
Arkansas Nat Company

NORTH

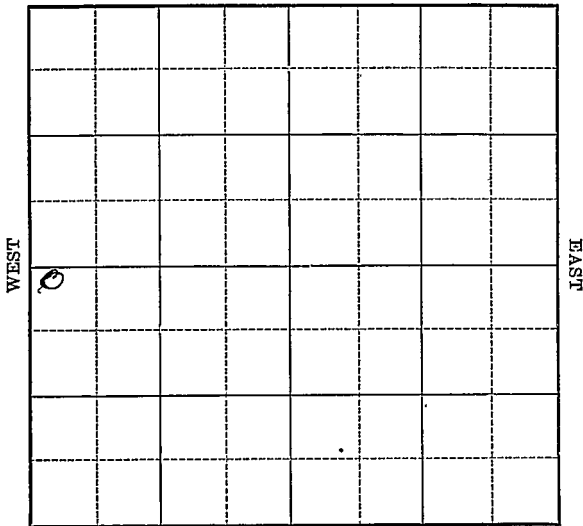

SOUTH

Location _____

Drilling Remarks:

RECORD

Cased _____ in. _____ ft.

Sand _____

Gas _____

Oil _____

Total Depth _____

Rig Up **COMPLETED** _____

Drilling Remarks:

PRODUCTION

1st 24 hrs. Nat. _____

1st 24 hrs. after shot _____

Gas _____ cu. ft.

Dry Hole _____


Abandoned _____

Map No. ✓ Sec. 5 Twp. 32 R. 5

Well No. 1 Logan Farm
Bearsaw Nat. Company

Date Started _____ Ft. from N 200 S _____ E _____ W 300 line

NORTH Kansas

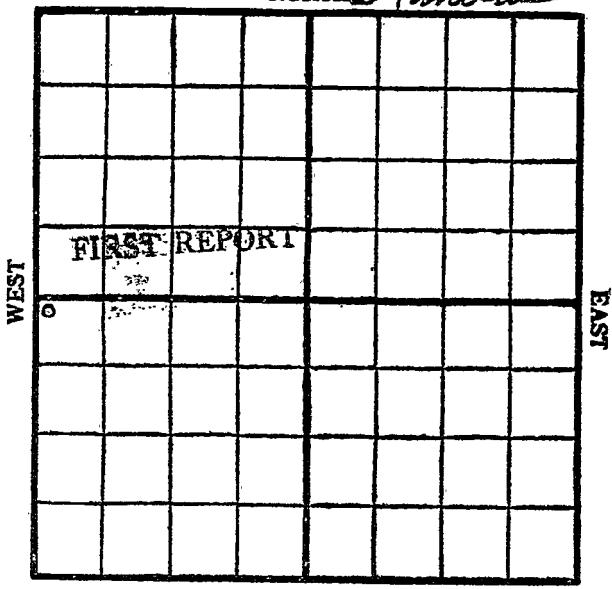

Cased _____ In. _____ Ft.	Production Remarks
Sand _____	
Pay { Gas _____	
Oil _____	
Total Depth _____	

Condition of Well on this date _____
2 Qly. at 1200'

M. A. BENEAR _____ Scout

Map No. *KV* Sec. *5* Twp. *32* R. *5*

Well No. *1 Lowe*
Parkers Nat. Company

Contractor

COMPLETED

SECTION PLAT

ABANDONED

200 Ft. from N. Line
 _____ Ft. from S. Line
 _____ Ft. from E. Line
200 Ft. from W. Line

0			

Location _____

Rig up _____

Drilling and Remarks:

L.O. & A. at
2340'

RECORD

Cased _____ in., _____ ft.
 Sand _____
 Gas _____
 Oil _____
 Total Depth _____

PRODUCTION

1st 24 hrs. Nat. _____
 1st 24 hrs. after shot _____
 Gas _____ Cu. Ft.
 Dry Hole _____
 Abandoned _____

Date
FEB 18 1922

M. A. BENEAR

_____ 191 _____ Scout