


Map No. _____ Sec. 36 Twp. 32 R. 4
 Well No. 1 Peacock Farm _____
J. B. Price Company _____

NORTH

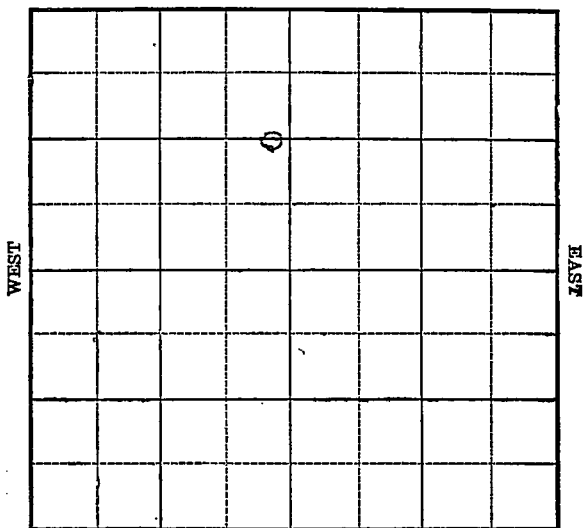

SOUTH

Location _____

Drilling Remarks:

Rig up _____

Drilling Remarks:

RECORD

Cased _____ in. _____ ft.

Sand _____

Gas _____

Oil _____

Total Depth _____

PRODUCTION

1st 24 hrs Nat. _____

1st 24 hrs. after shot _____

Gas _____ cu. ft.

Dry Hole _____

Abandoned _____

Map No. _____ Sec. 36 Twp. 32 R. 4

Well No. 1 Peacock Farm _____
L. B. Prince Company _____

NORTH

1320 Ft. from N. Line


_____ Ft. from S. Line

200 Ft. from E. Line

_____ Ft. from W. Line

WEST

EAST

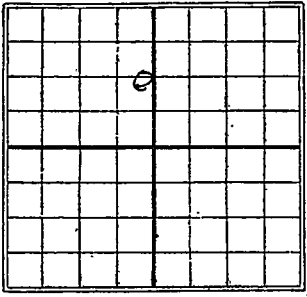

SOUTH

Date
1923

REPORT

2/24 Rgn. up Mch.
4/7 Sand 1485-91 - Shot
30 ts. 25 Bblo.
7/16 Camp.

Map No. **KANSAS** Sec. **36** Twp. **32** R. **4**
 Well No. **L. D. Price** Company _____ Contractor _____

FIRST REPORT

1320 Ft. from N. Line
 _____ Ft. from S. Line
200 Ft. from E. Line
 _____ Ft. from W. Line

SECTION PLAT

	3		

Location _____
 Rig up _____
 Drilling and Remarks:

*Rig up
Machine*

RECORD

Cased _____ in., _____ ft.
 Sand _____
 Gas _____
 Oil _____
 Total Depth _____

PRODUCTION

1st 24 hrs. Nat. _____
 1st 24 hrs. after shot _____
 Gas _____ Cu. Ft.
 Dry Hole _____
 Abandoned _____

Date

FEB 24 1923

M. A. BENEAR

Scout

Map No. 2 Kans 36 Sec. 36 Twp. 32 R. 4Well No. 1 Seacock
L. B. Price Company

Contractor

COMPLETE


SECTION PLAT

1320' Ft. from N. Line

_____ Ft. from S. Line

200' Ft. from E. Line

_____ Ft. from W. Line

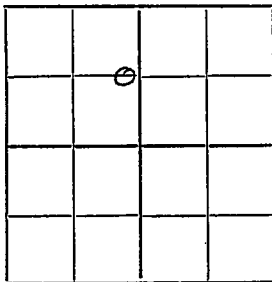

Location _____

Rig up _____

Drilling and Remarks:

sand-1485-91
shot 30 qts.
25 flls.
camp.

RECORD

Cased _____ in., _____ ft.

Sand _____

Gas _____

Oil _____

Total Depth _____

PRODUCTION

1st 24 hrs. Nat. _____

1st 24 hrs. after shot _____

Gas _____ Cu. Ft.

Dry Hole _____

Abandoned _____

Date

MA 7/23/24
192 Scout