

Map No. Kans Sec. 36 Twp. 32 R. 4

Well No. 3 Peacock Farm


Price et al Company

1120 Ft. from N. Line

..... Ft. from S. Line

200 Ft. from E. Line

..... Ft. from W. Line

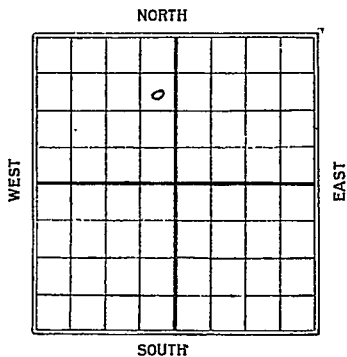

Date	REPORT
1925	
1/24	1490-1501 20 gts
	30 Bbls oil
	50 " Water

Map No. 2 **KANSAS** Sec. 36 Twp. 32 R. 4

Well No. 3 Peacocks

Quire etal Company

Contractor

**FIRST REPORT
COMPLETED**

SECTION PLAT

	o		

1120 Ft. from N. Line

_____ Ft. from S. Line

200 Ft. from E. Line

_____ Ft. from W. Line

Location _____

Rig up _____

Drilling and Remarks: _____

1490 - 1501'

25/30 oil
50 water

RECORD

Cased _____ in., _____ ft.

Sand _____

Gas _____

Oil _____

Total Depth _____

PRODUCTION

1st 24 hrs. Nat. _____

1st 24 hrs. after shot _____

Gas _____ Cu. Ft.

Dry Hole _____

Abandoned _____

Date

1/24

1925

M. A. BENEAR

Scout