


Map No. Kans Sec. 36 Twp. 32 R. 4

Well No. 2 Peacock Farm _____
Empire Company

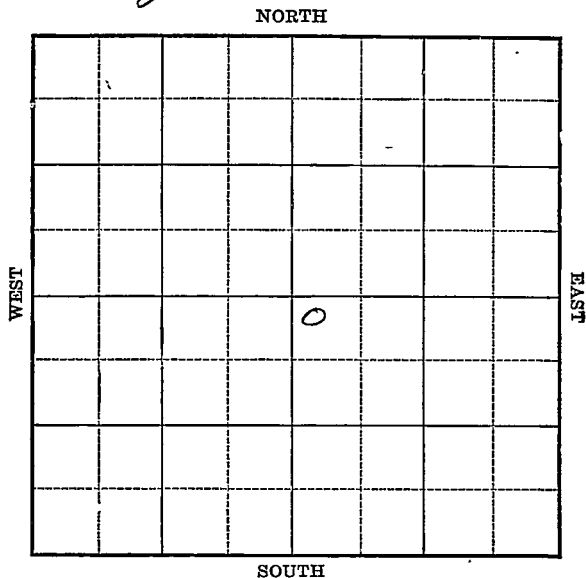

Location _____

Drilling Remarks _____

Rig Up _____

Drilling Remarks _____

RECORD

Cased _____ in. _____ ft.

Sand _____

Gas _____

Oil _____

Total Depth _____

PRODUCTION

1st 24 hrs. Nat. _____

1st. 24 hrs. after shot _____

Gas _____ cu. ft.

Dry Hole _____

Abandoned _____

Map No. Kans Sec. 36 Twp. 32 R 4

Well No. 2 Beaversk Farm


Empire Company

200 Ft. from N. Line

..... Ft. from S. Line

..... Ft. from E. Line

200 Ft. from W. Line

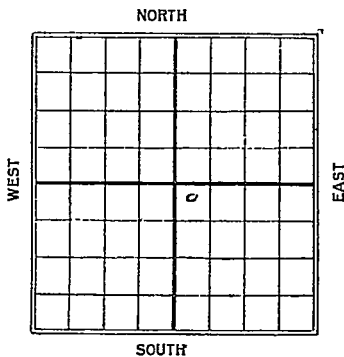

Date
1924

REPORT

1/24 Sand 1423-40 (Don't know
what it made) (Beaversk)

Map No. 2 **KANSAS** Sec. 36 Twp. 32 R. 4

Well No. 2 Peacock

Empire Company

FIRST REPORT

Contractor

SECTION PLAT

200 Ft. from N. Line

_____ Ft. from S. Line

_____ Ft. from E. Line

200 Ft. from W. Line

		o	

Location _____

Rig up _____

Drilling and Remarks:

0.1423-40

Cont / Know what it made

RECORD

Cased _____ in., _____ ft.

Sand _____

Gas _____

Oil _____

Total Depth _____

PRODUCTION

1st 24 hrs. Nat. _____

1st 24 hrs. after shot _____

Gas _____ Cu. Ft.

Dry Hole _____

Abandoned _____

Date

1/24

1925

M. A. BENEAR

Scout