

KANSAS

FORM 51 5M BRIX


Barton County

Section 7 Township 16 Range 11W

Well No. #1 Esfeld

Company Phil-Man

Kraft-Prusa NORTH

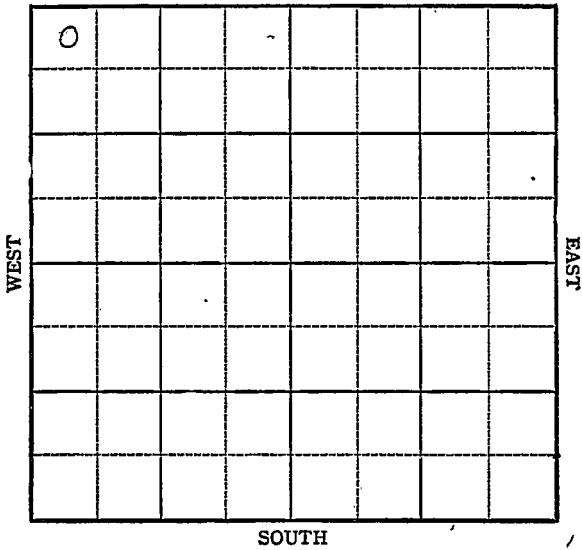

KANSAS

Barton County

Sec. 7 Twp. 16 R. 11W

Well No. #1 Esfeld Farm

Phil-Han Company


Kraft-Prusa

330 Ft. from N. Line

 Ft. from S. Line

 Ft. from E. Line

330 Ft. from W. Line

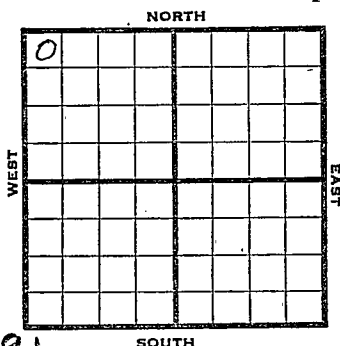

NW/c Elev. 1891

1944

R E P O R T

10/25

RUR

11/2

8" @ 462 Drlg. 2400

11/8

Lans 3023

Arb 3313-17 TD

11/16

5" @ 3315 RUST

TD 3323 $\frac{1}{2}$ 2800' oil

11/24

" " " " " "

11/29

" " " " " "

12/6

" " " " " "

12/14

" " " "

12/21

" " " "

12/29

" " " "

1945

1-3

Arbuckle 3313

Total Depth 3323 $\frac{1}{2}$

5" @ 3315

Echo Potential 1353

Gravity 42.4


COMPLETED

Pool Name Kraft-PrusaMap No. KANSAS Sec. 7 Twp. 16 R. 11WWell No. 1 EsfeldPhil-an Company

FIRST REPORT Contractor

NW/c

SECTION PLAT

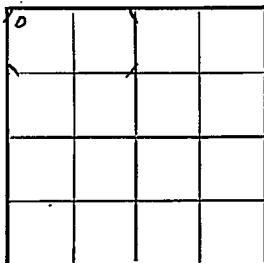330 Ft. from N. Line Ft. from S. Line Ft. from E. Line330 Ft. from W. LineBartonLocation Rig up

Drilling and Remarks:

R U R

RECORD

Cased in, ft.Sand Gas Oil Total Depth

PRODUCTION

1st 24 hrs. Nat. 1st 24 hrs. after shot Gas Cu. Ft.Dry Hole Abandoned

Date

OCT 25 1944 19S. J. LEWIS Scout

Pool Name Kraft-PrusaMap No. 55 Sec. 7 Twp. 16 R. 11WWell No. 1 EsfeldPhil-Hart CompanyCOMPLETED Contractor

NW/c

SECTION PLAT

330 Ft. from N. Line Ft. from S. Line Ft. from E. Line330 Ft. from W. Line

0			

BartonLocation Rig up

Drilling and Remarks:


RECORD

Cased in., ft.Sand Gas Oil Total Depth 3329 1/2

PRODUCTION

1st 24 hrs. Nat. 1st 24 hrs. after shot Gas Cu. Ft.Dry Hole Abandoned

Date

JAN 3 1945 19 S. J. LEWIS Scout