


Section 21 Township 25 Range 5-E

Well No. #157 Chesney

Company Cities Service

Miscellaneous

NORTH

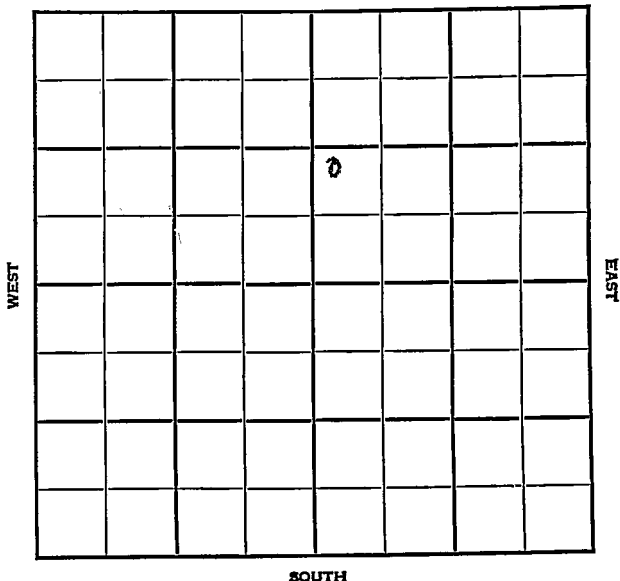

KANSAS

Butler



Sec. 21 Twp. 25 R. 5E

Well No. #157 Chesney Farm

Cities Service Company


Miscellaneous

 Ft. from N. Line

990' Ft. from S. Line

 Ft. from E. Line

330' Ft. from W. Line

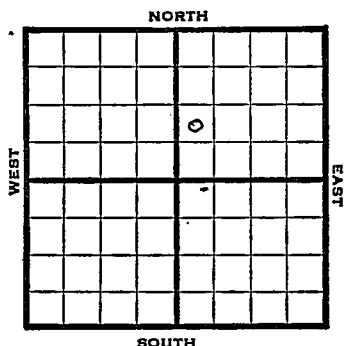

NW SW NE

1948

Eli 1355'

REPORT

6/16

10" @ 85'
Douglas 1434'
TD 1438'
7" @ 1434'

6/23

TD 1489'

6/29

"

7/14

TD 1489' ---
Douglas 1434'
7" @ 1434'
Pump 92 Oil / 25 W Pot
36° Gr.
Comp.

COMPLETED


Map No. _____ Sec. 21 Twp. 25 R. 5EWell No. 157 Chesney

Cities Service _____ Company

FIRST REPORT _____ Contractor

NW SW NE

SECTION PLAT

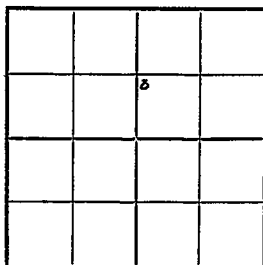

_____ Ft. from N. Line

990 Ft. from S. Line

_____ Ft. from E. Line

330 Ft. from W. Line

Butler County

Location _____

Rig up _____

Drilling and Remarks:

10" @ 85

Douglas 1434

TD 1438

7" @ 1434

RECORD

Cased _____ in., _____ ft.

Sand _____

Gas _____

Oil _____

Total Depth _____

PRODUCTION

1st 24 hrs. Nat. _____

1st 24 hrs. after shot _____

Gas _____ Cu. Ft.

Dry Hole _____

Abandoned _____

Date

JUN 16 1948 19 _____ S. J. LEWIS _____ Scout

Map No. 14 Sec. 21 Twp. 25 R. 5EWell No. 157 ChesneyCities Service CompanyCOMPLETE Contractor
NW SW NE E1, 1353

SECTION PLAT

		4	

Ft. from N. Line990 Ft. from S. LineFt. from E. Line330 Ft. from W. LineButler County

Location _____

Rig up _____

Drilling and Remarks:

Douglas 14342 1/2" @ 1434Prod 92 oil + 25 H₂OBT360 SW

RECORD

Cased _____ in., _____ ft.

Sand _____

Gas _____

Oil ☒ _____Total Depth 1489

PRODUCTION

1st 24 hrs. Nat. _____

1st 24 hrs. after shot _____

Gas _____ Cu. Ft.

Dry Hole _____

Abandoned _____

Date

JUL 14 1948

19

S. J. LEWIS

Scout