

Section 21 Township 25 Range 5-EWell No. #158 ChesneyCompany Cities Service

NORTH

WEST

EAST

SOUTH

KANSAS

Butler

Sec. 21 Twp. 25 R. 5E

Well No. #158 Chesney Farm

Cities Service

Company

Miscellaneous

 Ft. from N. Line

305'


 Ft. from S. Line

 Ft. from E. Line

397'

 Ft. from W. Line

SW NE

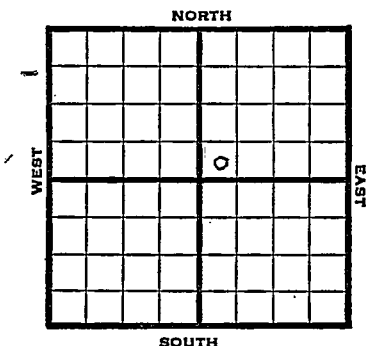

1948

Elev. 1367' REPORT

7/14 10" @ 84'

WOC

7/21 "

7/28 "

8/4 Drlg. 1420'

8/11 Douglas 1432'

7" @ 1432'

TD 1494'

Pump 90 oil & 3 W Pot.

Gr. 38°

COMPLETED

Map No. _____ Sec. 21 Twp. 25 R. 5E

Well No. 158 Chesney

Cities Service Company

FIRST REPORT

Contractor _____

SW NE

SECTION PLAT

_____ Ft. from N. Line

305 Ft. from S. Line

_____ Ft. from E. Line

397 Ft. from W. Line

Butler County

Location _____

Rig up _____

Drilling and Remarks:

10" @ 84 WOC

RECORD

Cased _____ in., _____ ft.

Sand _____

Gas _____

Oil _____

Total Depth _____

PRODUCTION

1st 24 hrs. Nat. _____

1st 24 hrs. after shot _____

Gas _____ Cu. Ft.

Dry Hole _____

Abandoned _____

Date

JUL 14 1948

19

S. J. LEWIS

Scout

Butler County Kansas - StateMap No. 1A Sec. 21 Twp. 25 R. 5EWell No. 158 ChesneyCities Service Company**COMPLETE**

SW NE Contractor

E 11867

SECTION PLAT

 Ft. from N. Line305 Ft. from S. Line Ft. from E. Line397 Ft. from W. LineMiscellaneous

Remarks:

*Douglas 1432**7" @ 1432**YD 1494**Pump 900il + 3W BX**38°/4*Date
AUG 11 1948Scout S. J. LEWIS