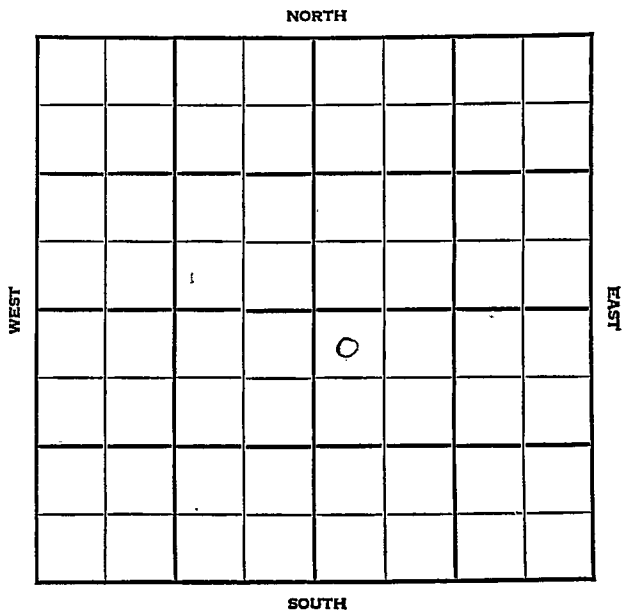


KANSAS

Section 21 Township 25 Range 5EWell No. 155 ChesneyCompany Cities Service

Sec. 21 Twp. 25 R. 5E

Well No. #155 Chesney Farm

Cities Service Company

Misc.


317 Ft. from N. Line

 Ft. from S. Line

 Ft. from E. Line

360 Ft. from W. Line

NW SE

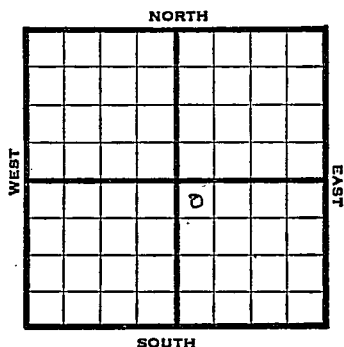

1948

Elev 1370'

REPORT

4/28

10" @ 78'
Drlg. 890'

5/5

KC 1912'
TD 1916'
7" @ 1915'
RUST

5/12

"

5/19

"

5/26

Brlg. 1975'

6/1

TD 2030'

6/9

"

6/16

TD 2030'
KC 1912'
7" @ 1915'
5000 acid
Pump 100 Oil / 40 W Pot
38° Gr.
Comp.

COMPLETED

Map No. _____ Sec. 21 Twp. 25 R. 5EWell No. 155 Chesney

_____ Cities Service _____ Company

FIRST REPORT

_____ Contractor


NW SE

SECTION PLAT

317 Ft. from N. Line

_____ Ft. from S. Line

_____ Ft. from E. Line

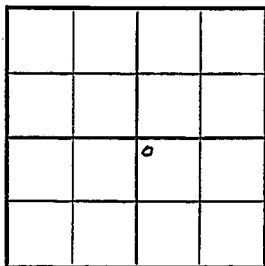360 Ft. from W. Line

Butler County

Location _____

Rig up _____

Drilling and Remarks:

10" @ 78

drlg. 890

RECORD

Cased _____ in., _____ ft.

Sand _____

Gas _____

Oil _____

Total Depth _____

PRODUCTION

1st 24 hrs. Nat. _____

1st 24 hrs. after shot _____

Gas _____ Cu. Ft.

Dry Hole _____

Abandoned _____

Date

APR 28 1948

19

S. J. LEWIS Scout

Map No. 14 Sec. 21 Twp. 25 R. 5EWell No. 155 ChesneyCities Service Company**COMPLETE**

Contractor

NW SE

E11370

SECTION PLAT

		0	

317 Ft. from N. Line Ft. from S. Line Ft. from E. Line360 Ft. from W. LineButler CountyLocation Rig up

Drilling and Remarks:

HC 19122" @ 19155000 ac oilPump 100 oil + 40WPSH28°/4

RECORD

Cased in., ft.Sand Gas Oil ✓Total Depth 2030

PRODUCTION

1st 24 hrs. Nat. 1st 24 hrs. after shot Gas Cu. Ft.Dry Hole Abandoned

Date

JUN 1 6 1948

19

S. J. LEWIS Scout