

KANSAS

Barton


Form 51-5M-7-40-Palace

Section 6 Township 16 Range 11-W

Well No. 1 Lillard

Company ~~Isern Bros.~~ Sharon Drilling

NORTH Wildcat

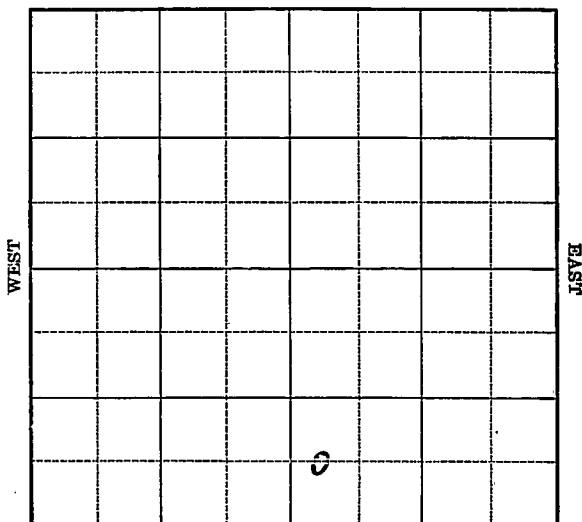

SOUTH

Barton

Sec. 6 Twp. 16 R. 11-W

Well No. #1 Lillard Farm

Isern Bros. Sharon Drlg. Company
(Wildcat) NORTH


Ft. from N. Line

660 Ft. from S. Line

Et. from E. Line

330 Ft. from W. Line

Elev. 1804

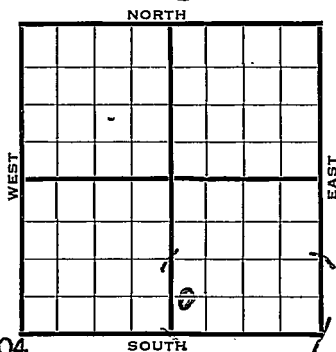

<u>1941</u>	REPORT
<u>1/22</u>	8" - 63' WOC.
<u>1/30</u>	Anhy 686' Drlg. 2380'
<u>2/6</u>	Topeka 2605' Lans. 2968'
	Sooy 3255' Arb. 3271'
	Coring 3278'
<u>2/13</u>	4" - 3272' RUST.
	Arb. 3271-78' T.D.
<u>2/20</u>	" " "
<u>2/27</u>	P.B. to 3268' 4 gals. oil 3 hours.
<u>3/6</u>	1500 acid. Jet 3273
	T.D. 3275' 1200 Jet.
	SO & W. T.D. 3276'
	Jet 1200 acid. Water.
	OVER

1941
3/12

Arb. 3271'

4" - 3272'

T.D. 3278'

4400 acid.

Water.

ABANDONED

Map No. 55 Sec. 6 Twp. 16 R. 11WWell No. 1 LillardIsern Bros.

Company

Contractor

FIRST REPORT

C W L SW SE

 Ft. from N. Line660 Ft. from S. Line Ft. from E. Line330 Ft. from W. Line

WILDCAT

SECTION PLAT

Location Rig up

Drilling and Remarks:

8" - 63WOC

RECORD

Cased in., ft.Sand Gas Oil Total Depth

PRODUCTION

1st 24 hrs. Nat. 1st 24 hrs. after shot Gas Cu. Ft.Dry Hole Abandoned

Date

JAN 22 1941 19S. J. LEWIS

Scout

Map No. _____ Sec. 6 Twp. 16 R. 11W

Well No. 1 Lillard

Sharon Drilling Company

CORRECTION Contractor

SECTION PLAT

C W L SW SE

_____ Ft. from N. Line

660 Ft. from S. Line

_____ Ft. from E. Line

330 Ft. from W. Line

WILDCAT

Location _____

Rig up _____

Drilling and Remarks:

Sharon Drlg.

Took this over
from Isern Bros.

RECORD

Cased _____ in., _____ ft.

Sand _____

Gas _____

Oil _____

Total Depth _____

PRODUCTION

1st 24 hrs. Nat. _____

1st 24 hrs. after shot _____

Gas _____ Cu. Ft.

Dry Hole _____

Abandoned _____

Date

MAR 12 1941 19

J. LEWIS Scout

Map No. 55 Sec. 6 Twp. 16 R. 11WWell No. 1 Lillard

Sharon Drilling Company

Contractor

ABANDONED

C W L SW SE

Ft. from N. Line

660 Ft. from S. Line

Ft. from E. Line

330 Ft. from W. Line

WILDCAT

SECTION PLAT

Location _____

Rig up _____

Drilling and Remarks:

*Cor 83271**4" @ 3272**H400 @ 3210**Watered.*

RECORD

Cased _____ in., _____ ft.

Sand _____

Gas _____

Oil _____

Total Depth *8275*

PRODUCTION

1st 24 hrs. Nat. _____

1st 24 hrs. after shot _____

Gas _____ Cu. Ft.

Dry Hole _____

Abandoned _____

Date

MAR 12 1941 19

S. J. LEWIS Scout

Check company name. Our records
show Isern Bros. as the operator.

Paul.

Misc. Small	Paul
Cards	Paul
Tr. ng.	Joe
