
FORM 5I 5M PETROL

KANSAS Barton

Section 7 Township 16 Range 11W

Well No. 3 Esfeld

Company Globe Oil & Ref. etal

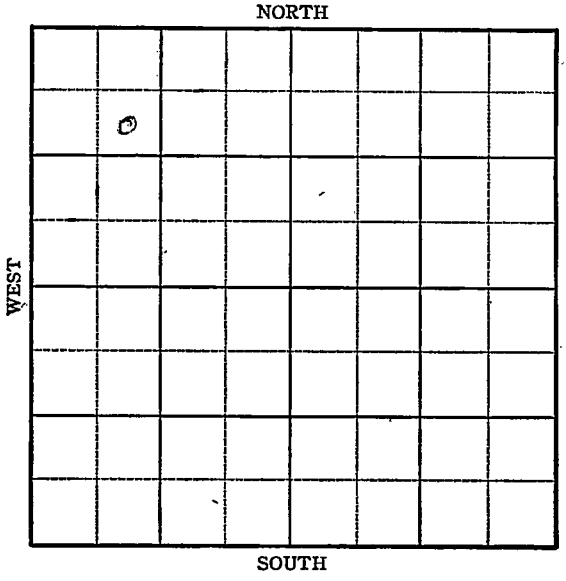

FORM 252-A
5M 8-45 PETROL

KANSAS Barton

Sec. 7 Twp. 16 R. 11-W

Well No. #3 Esfeld Farm

Globe Oil & Ref. et al Company

(was Phil-Han)


990 Ft. from N. Line

Ft. from S. Line

Ft. from E. Line

990 Ft. from W. Line

SE NW NW

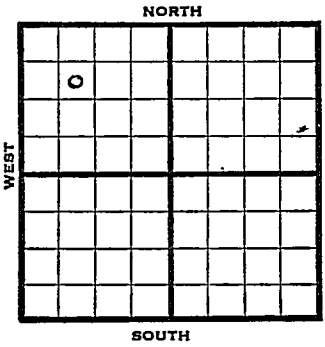

1945	Elev. 1880' REPORT
11/28	8" @ 258' Drlg. 3085'
12/5	Arb. 3323-3330 TD 3330'
12/12	5" @ 3324 RUST
12/20	Lans. 3030' Cong 3302'.
12/29	T.D. 3330' 2800' oil 24 hours.
1946	
1/10	" " "
1/17	" " "
1/24	" " "
1/31	" " "
2/6	Arb. 3323 5" @ 3324 TD 3330 Pump 307 Pot. Grav. 42.0

COMPLETED

FORM 26 200 BKS. 1-44 PETROL

KANSAS Kansas Pool Name Kraft-Prusa

Map No. S S Sec. 7 Twp. 16 R. 11W

Well No. 3 Esfeld

Globe Oil and Ref. etal Company

FIRST REPORT Contractor

SE NW NW

990 Ft. from N. Line


Ft. from S. Line

Ft. from E. Line

990 Ft. from W. Line

Barton County

SECTION PLAT

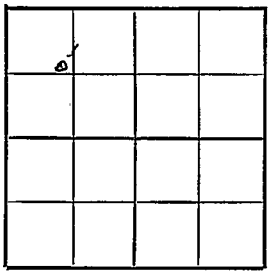

Location

Rig up

Drilling and Remarks:
was Phil-Han
8"-258 3085

RECORD

Cased in., ft.

Sand

Gas

Oil

Total Depth

PRODUCTION

1st 24 hrs. Nat.

1st 24 hrs. after shot

Gas Cu. Ft.

Dry Hole

Abandoned

Date

NOV 2 8 1945 19

S. J. LEWIS Scout

FORM 26 200 BKS 2-44 PETROL

KANSAS Kansas Pool Name Kraft-Prusa

Map No. 55 Sec. 7 Twp. 16 R. 11W

Well No. 3 Esfeld


Globe Oil and Ref. etal Company

COMPLETED Contractor

SE NW NW

El. 1880

SECTION PLAT

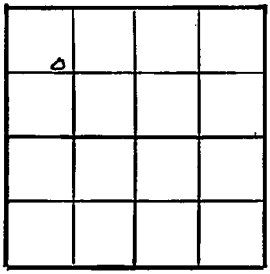

990 Ft. from N. Line

Ft. from S. Line

Ft. from E. Line

990 Ft. from W. Line

Barton County

Location

Rig up

Drilling and Remarks:

Cer #23323

5-1 #23324

Pmy 807 BT

42 ° Gr

RECORD

Cased in., ft.

Sand

Gas

Oil

Total Depth 3330

PRODUCTION

1st 24 hrs. Nat.

1st 24 hrs. after shot

Gas Cu. Ft.

Dry Hole

Abandoned

Date

FEB 6 1946 19

S. J. LEWIS Scout