


Map No. Kansas Sec. 7 Twp. 28 R. 14 ~~15~~

Well No. 1 Damon Farm
O. W. Culp Company

NORTH

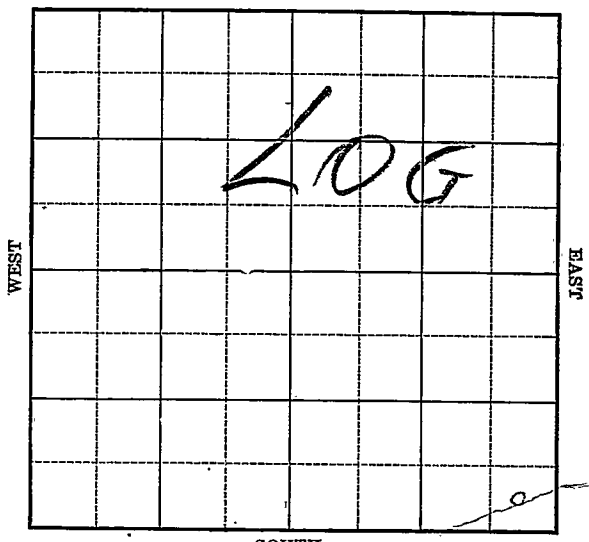

Location _____

Drilling Remarks _____

RECORD

Cased _____ in. _____ ft.

Sand _____

Gas _____

Oil _____

Total Depth _____

Rig Up _____

Drilling Remarks _____

PRODUCTION

1st 24 hrs. Nat. _____

1st 24 hrs. after shot _____

Gas _____ cu. ft.

Dry Hole _____


Abandoned _____

Wilson Co

Map No. Kansas Sec. 7 Twp. 28 R. 14

Well No. 1 Harmon Farm
O. W. Culp Company

_____ Ft. from N. Line
660 Ft. from S. Line
660 Ft. from E. Line
 _____ Ft. from W. Line

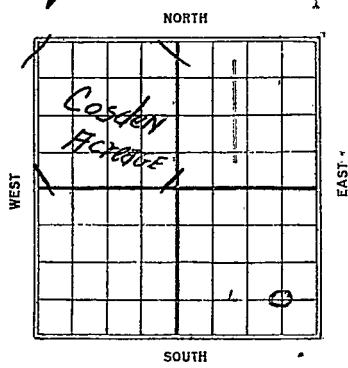

Date	REPORT
<u>12/22</u>	
<u>11/21</u>	<u>Spudding</u>
<u>12/27</u>	_____
<u>12/3</u>	<u>RF # 575' only 785'</u>
<u>12/10</u>	<u>only up casing shoe 975'</u>
<u>12/18</u>	<u>Top man line</u>
<u>12/17</u>	_____
<u>12/23</u>	<u>Same. S. D.</u>
<u>12/31</u>	_____
<u>1926</u>	
<u>1/8</u>	_____
<u>1/14</u>	_____
<u>1/20</u>	<u>S. & A. 1528</u>

Map No. *Wagon* **KANSAS** Sec. *7* Twp. *28* R. *13*

Well No. *1* **Hamon**
O. H. Culp Company

Contractor

*Correction
Following*

SECTION PLAT

	MID-		
	-CONT		
			o

_____ Ft. from N. Line

660

_____ Ft. from S. Line

660

_____ Ft. from E. Line

_____ Ft. from W. Line

FIRST REPORTS

Location _____

Rig up *"Machine"*

Drilling and Remarks:

Spudding.

RECORD

Cased _____ in., _____ ft.

Sand _____

Gas _____

Oil _____

Total Depth _____

PRODUCTION

1st 24 hrs. Nat. _____

1st 24 hrs. after shot _____

Gas _____ Cu. Ft.

Dry Hole _____

Abandoned _____

Date

NOV 21 1925

CHAS. L. SHERWOOD

192

Scout

Adm:-

Yes this should be in Range

147 as I thought I reported it

shot. advise if you want a correction
ticket.

Chas.

SCOUTS TELEPHONE REPORT

_____ M _____ 19 _____

26 7-28-13
#1 Hamster
O.W. Culp

Map No. 1 Kansas 28 Sec. 17 Twp. 28 R. 14

Well No. #1 Damon

O. W. Culp Company

Contractor

SECTION PLAT

_____ Ft. from N. Line

660 Ft. from S. Line

660 Ft. from E. Line

_____ Ft. from W. Line

Correction change
From Range 13 to
Range 14

			0

Location _____

Rig up _____

Drilling and Remarks:

RECORD

Cased _____ in., _____ ft.

Sand _____

Gas _____

Oil _____

Total Depth _____

PRODUCTION

1st 24 hrs. Nat. _____

1st 24 hrs. after shot _____

Gas _____ Cu. Ft.

Dry Hole _____

Abandoned _____

Date

12/20 1925

Sherwood Scout

authority attached
for changing from
28-13 to 28-14

Returned	
Cards	<i>MB</i>
Tracing	
France Map	<i>W. Howard map</i>
Scarborough Map	
Moody Map	
Scarborough Plat Book	
Moody Plat Book	

*No WALL MAP
No SMALL MAP*

Mildred Co

no map

Map No. **KANSAS** Sec. *7* Twp. *28* R. *14*

Well No. *1* *Hamon*

O. W. Ouhp

Company

Contractor

COMPLETED

SECTION PLAT

			0

ABANDONED

Ft. from N. Line

660

Ft. from S. Line

660

Ft. from E. Line

Ft. from W. Line

Lease Contract

Location

Rig up

Drilling and Remarks:

Tap here 1448'
Dry & abandoned
20 1528'

RECORD

Cased _____ in., _____ ft.

Sand _____

Gas _____

Oil _____

Total Depth *1528'*

PRODUCTION

1st 24 hrs. Nat. _____

1st 24 hrs. after shot _____

Gas _____ Cu. Ft.

Dry Hole

Abandoned

Date

JAN 20 1926

192

CHAS. L. SHERWOOD

Scout