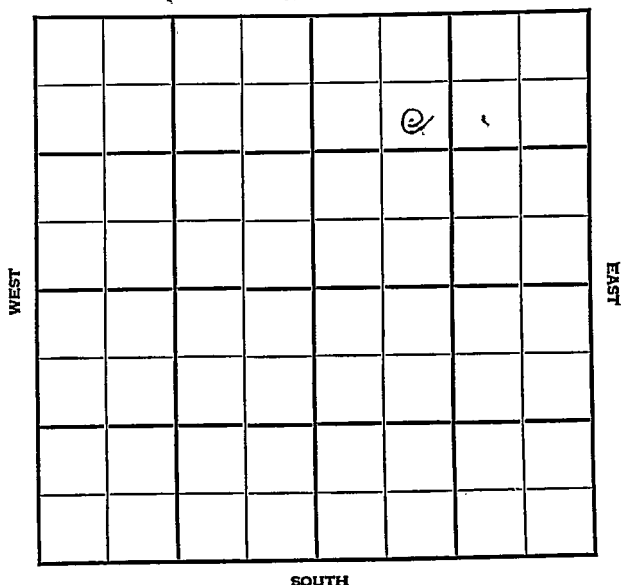


Section 21 Township 25 Range 5-EWell No. #156 ChesneyCompany Cities ServiceMiscellaneous
NORTH

KANSAS

Butler

Sec. 21 Twp. 25 R. 5EWell No. #156 Chesney (twin) Farm


Cities Service

Company

Misc.

 Ft. from N. Line990 Ft. from S. Line Ft. from E. Line990 Ft. from W. Line

NE SW NE

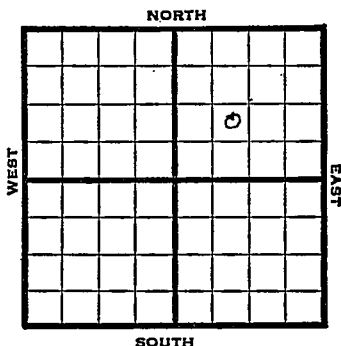

1948

Eli 1356'

REPORT

6/1 Location

6/9 Drlg. 1400'

6/16 Douglas 1431'

TD 1437'

7" @ 1431'

RUST

6/23 "

6/29 "

7/8 "

7/14 "

7/21 "

7/28 Douglas 1431'

7"@ 1431'

TD 1504'

Pump 85 oil / 15 W Pot
Comp.**COMPLETED**

Map No. _____ Sec. 21 Twp. 25 R. 5 e

Well No. 156 Chesney

Cities Service Company

FIRST REPORT

Contractor

NE SW NE

SECTION PLAT

570 Ft. from N. Line

990 Ft. from S. Line

_____ Ft. from E. Line

990 Ft. from W. Line

Butler County

Location X

Rig up _____

Drilling and Remarks:

twin well

RECORD

Cased _____ in., _____ ft.

Sand _____

Gas _____

Oil _____

Total Depth _____

PRODUCTION

1st 24 hrs. Nat. _____

1st 24 hrs. after shot _____

Gas _____ Cu. Ft.

Dry Hole _____

Abandoned _____

Date

JUN 1 1948

19

S. J. LEWIS

Scout

Butler County Kansas State

Map No. 14 Sec. 21 Twp. 25 R. 5E

Well No. 156 Chesney

Cities Service Company

COMPLETE

Contractor

NE SW NE

E. 1. 1356
SECTION PLAT

 Ft. from N. Line

990 Ft. from S. Line

 Ft. from E. Line

990 Ft. from W. Line

					0		

Miscellaneous

Remarks:

Douglas 431

7" @ 1431

X 131504

Pony Soil + 15 W. Rd.

3824
Date
JUL 28 1948

Scout
S. J. LEWIS