FORM 51


Barton

KANSAS

Section 7 Township 16 Range 11W

Well No. #1 Woydziak

Company V.E. Autry & Phil Davies.

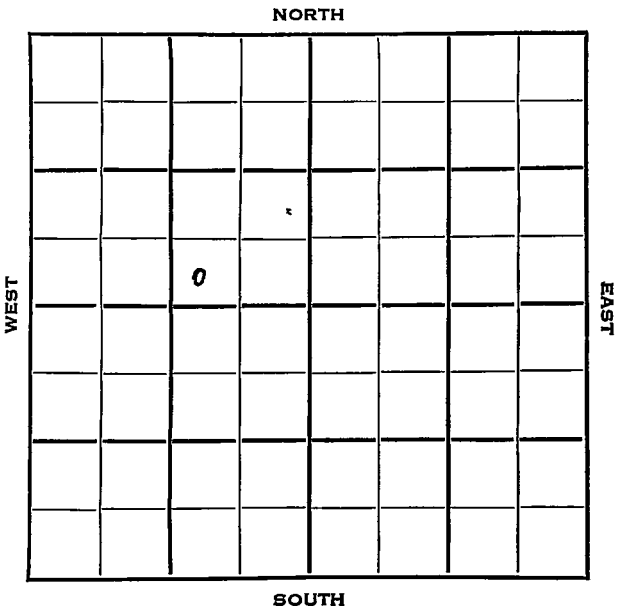

Barton KANSAS

SEC.	TWP.	R.
7	16	11 W

WELL NO.

1 Woydziak FARM

COMPANY

V. E. Autry & Phil Davies

CONTRACTOR

H. M. Williams

Kraft-Prusa Pool


_____ Ft. from N. Line

330 Ft. from S. Line

990 Ft. from E. Line

_____ Ft. from W. Line

SW SE NW

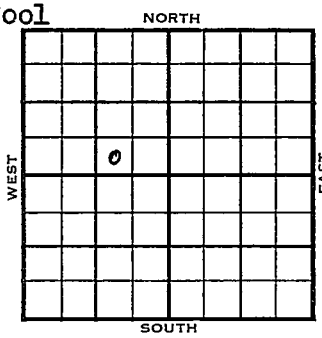

1954	ELEVATION 1840' REPORT
3/17	RUR
3/24	8" @ 235' w/225 sks
	Heeb 2888', Doug 2920', Br li 2980'
	Lans 2998'
	Drlg. 3077'
3/31	Spud 3-16-54
	D &A
	TD 3350'
	8" @ 235'
	Heeb 2888', Doug 2920', Br. Lime 2980'
	Lans 2998',
	DST 3169'-81' opn I hr, rec 15' socm
	O#
	Cong3285'
	TD 3350'
	D &A

ABANDONED

DX-78

FORM 275 FOR SALE BY KANSAS BLUE PRINT CO.


County Barton State Kansas

Sec. 7 (Blk. Twp.) 16 (Sur. Rge.) 11W Map No.

Operator V. E. Autry & Phil Davies

Well No. 1 Farm Woydziak

Elev. Location SW SE NW

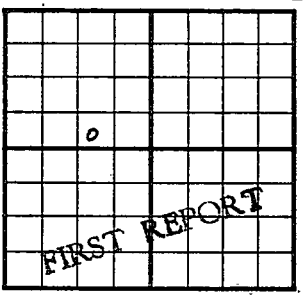

330 Ft. From S Line NW

990 Ft. From E Line Quarter

1st. Report MAR 17 1954

Completion

Remarks H.M. Williams - Contr.

Spudding Date

Drlg. Data Kraft-Prusa Pool

R U R

J. G. McGEHEE

FORM 275 FOR SALE BY KANSAS BLUE PRINT CO.


County Barton State Kansas

Sec. 7 (Blk. Twp.) 16 (Sur. Rge.) 11W Map No.

Operator V. E. Autry & Phil Davies

Well No. 1 Farm Woydziak

Elev. 1840 Location SW SE NW

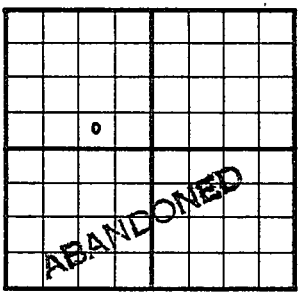

330 Ft. From S Line NW

990 Ft. From E Line Quarter

1st. Report

Completion MAR 31 1954

Remarks Kraft-Prusa Pool

H.M. Williams - Contr.

Spudding Date 3-16-54

Drlg. Data D & A TD 3350

8" @ 235 Heeb. 2888 Doug. 2920

Br. lime 2980 Lans. 2998 DST 3169-81

open 1 hr. Rec. 15' socm 0#

Cong. 3285 TD 3350

D & A

J. G. McGEHEE