Barton KANSAS

SECTION 8 TOWNSHIP 16 RANGE 11W

WELL NO. #1 J.O. Leary

COMPANY Wilkinson Drlg. Co.

NORTH NE NE NE

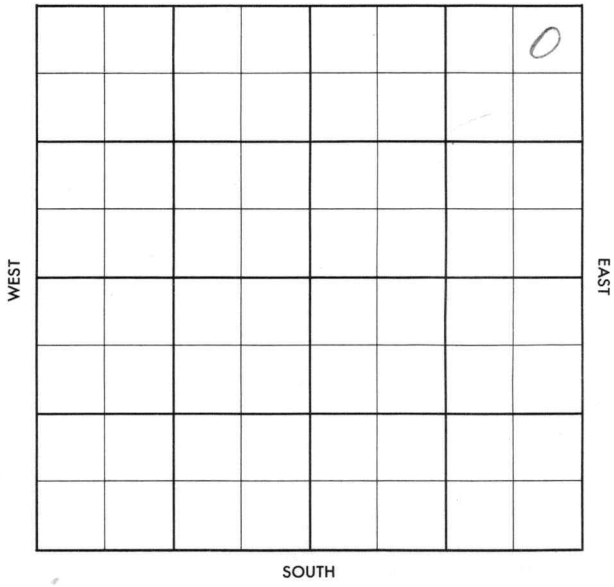

FORM 504-3 SUNRAY

FORM 513 SUNRAY

County Barton Elev.

Sec. 8 Twp. 16 Rge. 11W

Company Wilkinson Drlg. Co.

Farm Name J. O. Leary No. 1

TOPS	DEPTH	LOG	DATUM
Anh.	660-680		
T.P.			
H.			
Tr.			
Dg.			
B.L.			
L.			
K.C.			
B.K.C.			
Ce.			
C.			
M.			
M.			
K.			
Mz.			
Mq.			
V.			
S.			
S.			
A			
R.			
P€.			
G.			
T.D.			

Loc. in Sec. NE NE NE

Geol.

Contr. Co. Tools

Pool Kraft-Prusa

FIRST REPORT

JUN 12 '57

Date Comm. 6-7-57

8" @ 398/225, Drlg. 2470

Co. Lse. No. Sec. T. R.

FORM 513 SUNRAY

County Barton Elev. 1776

Sec. 8 Twp. 16 Rge. 11W

Company Wilkinson Drlg. Co.

Farm Name J. C. Leary No. 1

TOPS	DEPTH	LOG	DATUM
Anh.	660-680		
Tp.			
H.		2819	
Tr.			
Dg.			
B.L.		2911	
L.		2929	
K.C.			
B.K.C.			
Ce.			
C.		3231	
M.			
M.			
K.			
Mz.			
Mq.			
V.			
S.			
S.			
A		3267	
R.			
P€.			
G.			
T.D.	3302		

Loc. in Sec. NE NE NE

Geol.

Contr. Co. Tools

Pool Kraft-Prusa

JUL 10 '57 0

COMPLETE

Date Comm. 6-7-57

8" @ 398/225, Drlg. 2470 JUN 10 '57

DST 3014-25 op 90" 2600

Gip rec 55' VHO & GCM +105'

Froggy oil +15' wtr BHP

691/20" 5½ 3278/135 WOC

JUN 26 '57 CO 3233 PF 3017-28

B ½ GFPh 50% oil 1/4 B & E

Flwd 15 Bophnolw 4 hrs T&R

JUL 3 '57 JUL 10 '57 ~~[illegible]~~ P. 25 Bopd

nolwtr

Co. Lse. No. Sec. T. R.