


Barton

KANSAS

SECTION 8 TOWNSHIP 16S RANGE 11W

WELL NO. #3 O'Leary

COMPANY Wilkinson Drlg.

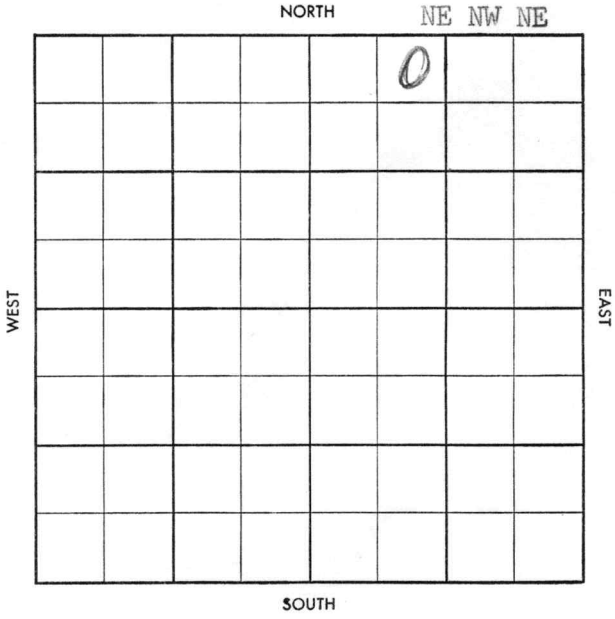

CO. Barton ELEV. _____

SEC. 8 TWP. 16 RGE. 11W

COMPANY Wilkinson Drlg NO. 3

NOV 13 57		
FIRST REPORT		

FARM O'Leary

LOC. NE NW NE

GEOL. _____

CONTR. Co. Tools rig #2

POOL Kraft Prusa

SPUD 11/11/57

8" @ 393.04 w/200, WOC

~~13~~

CO.
LSE.
NO.
SEC.
TWP.
RGE.

