
FORM 51 10M 8-47

KANSAS Barton

Section 8 Township 16 Range 11W

Well No. #2 Mueller

Company N C R A

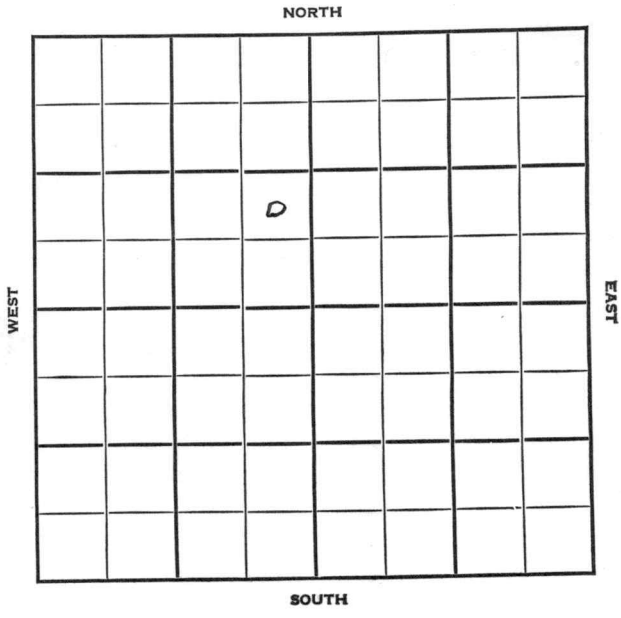

FORM 252-A
5M 9-47 PETROL

KANSAS Barton

Sec. 8 Twp. 16 R. 11W

Well No. #2 Mueller Farm

N C R A Company
Kraft-Prusa


Ft. from N. Line

990 Ft. from S. Line

330 Ft. from E. Line

Ft. from W. Line

NE SE NW

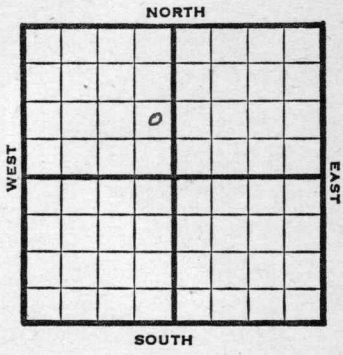

1948	Elev. 1834' REPORT
1/21	Location
1/26	"
2/4	"
2/11	12" @ 421' 708' run 10"
2/18	8"@ 708' Drlg 1365'
2/25	Drlg. 2310'
3/3	Drlg. 2430'
3/10	Drlg. 2470'
3/17	SD
3/24	Drlg. 2720'
3/31	Drlg. 3040'
4/7	7" @ 3131' Drlg. 3190'
4/14	Lans. 2987' Arb. 3313' TD 3315' Abd.

ABANDONED

Form 26 200 Bks. 10-46 Petrol

Kansas

Kraft-Prusa Pool

Map No. _____ Sec. 8 Twp. 16 R. 11W

Well No. 2 Mueller

N C R A


Company

FIRST REPORT

Contractor

NE SE NW

SECTION PLAT

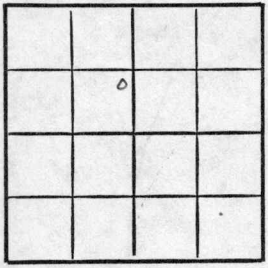

_____ Ft. from N. Line

990 Ft. from S. Line

330 Ft. from E. Line

_____ Ft. from W. Line

Barton County

Location x

Rig up

Drilling and Remarks:

RECORD

Cased _____ in., _____ ft.

Sand

Gas

Oil

Total Depth

PRODUCTION

1st 24 hrs. Nat.

1st 24 hrs. after shot

Gas _____ Cu. Ft.

Dry Hole

Abandoned

Date

JAN 21 1948

19

S. J. LEWIS Scout

Kraft-Prusa Pool

Form 26—200 Bks.—1-48—Palace

Kansas

Map No. 55 Sec. 8 Twp. 16 R. 11W

Well No. 2 Mueller


N C R A Company

ABANDONED Contractor

NE SE NW

E. 1184

SECTION PLAT

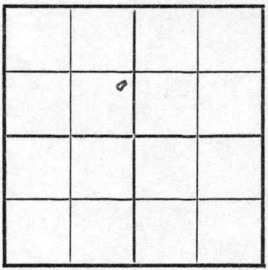

____ Ft. from N. Line

990 Ft. from S. Line

330 Ft. from E. Line

____ Ft. from W. Line

Barton County

Location

Rig up

Drilling and Remarks:

Lime 2987

TD 3315

RECORD

Cased ____ in., ____ ft.

Sand

Gas

Oil

Total Depth 3315

PRODUCTION

1st 24 hrs. Nat.

1st 24 hrs. after shot

Gas ____ Cu. Ft.

Dry Hole

Abandoned

Date

APR 14 1948 19____ S. J. LEWIS Scout