

KANSAS Butler

Section 21 Township 25 Range 5E

Well No. 159 Chesney

[illegible]

Misc.

NORTH

WEST

EAST

SOUTH

KANSAS Butler

Sec. 21 Twp. 25 R. 5E ✓

Well No. 159 Chesney Farm

Cities Service Company
Misc.


290 Ft. from N. Line

 Ft. from S. Line

 Ft. from E. Line

950 Ft. from W. Line

NE NW SE

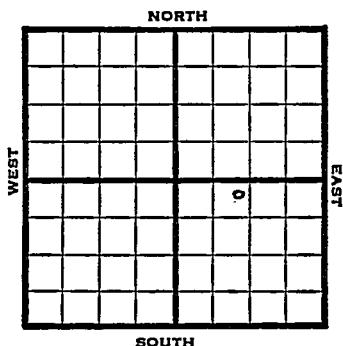

1948

Eli 1376'

REPORT

11/17

10" @ 83'

Drlg. 1000'

11/23

Douglas 1434-37'

TD 1437'

7" @ 1435'

11/30

TD 1476'

850' oil 9 hrs.

12/8

TD 1476'

Douglas 1434'

7" @ 1435'

Pump 101 Oil Pot

38° Gr.

Comp

COMPLETED

Map No. _____ Sec. 21 Twp. 25 R. 5EWell No. 159 Chesney

Cities Service _____ Company

FIRST REPORT _____ Contractor

NE NW SE

SECTION PLAT

290 Ft. from N. Line

_____ Ft. from S. Line

_____ Ft. from E. Line

950 Ft. from W. Line

		4	

Butler County

Location _____

Rig up _____

Drilling and Remarks:

10" @ 83

drlg. 1000

RECORD

Cased _____ in., _____ ft.

Sand _____

Gas _____

Oil _____

Total Depth _____

PRODUCTION

1st 24 hrs. Nat. _____

1st 24 hrs. after shot _____

Gas _____ Cu. Ft.

Dry Hole _____

Abandoned _____

Date

NOV 17 1948

19

S. J. LEWIS Scout

Map No. 14 Sec. 21 Twp. 25 R. 5E

Well No. 159 Chesney

Cities Service Company

COMPLETE

Contractor

NE NW SE

E11376
SECTION PLAT

290 Ft. from N. Line

 Ft. from S. Line

 Ft. from E. Line

950 Ft. from W. Line

Butler County

Location

Rig up

Drilling and Remarks:

Douglas 1484

7" @ 1485

Pump 10/ oil 1484

882/2

RECORD

Cased in., ft.

Sand

Gas

Oil ✓

Total Depth 1426

PRODUCTION

1st 24 hrs. Nat.

1st 24 hrs. after shot

Gas Cu. Ft.

Dry Hole

Abandoned

Date

DEC 8 1948 19

S. J. LEWIS Scout