KANSAS


Form 51—5M—11-38—Palace

Barton

Section 8 Township 16 Range 11-W

Well No. 1 Ney

Company Transwestern

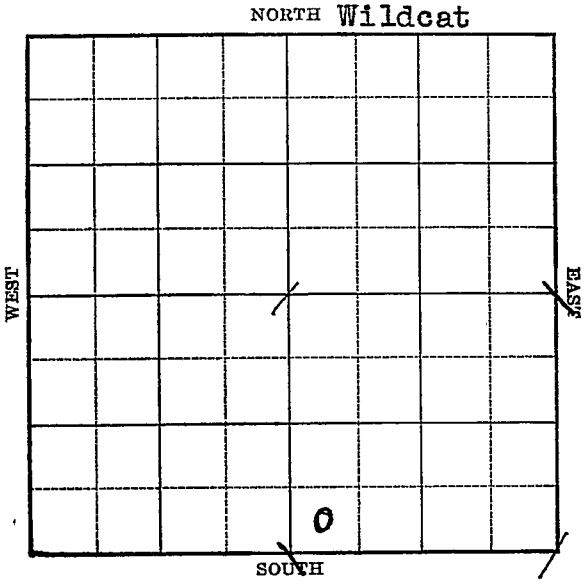

FORM 252-A 5M 10-38 KANSAS Barton

Sec. 8 Twp. 16 R. 11-W

Well No. #1 Ney Farm

Transwestern Company


(Wildcat)

____ Ft. from N. Line

330 Ft. from S. Line

____ Ft. from E. Line

330 Ft. from W. Line

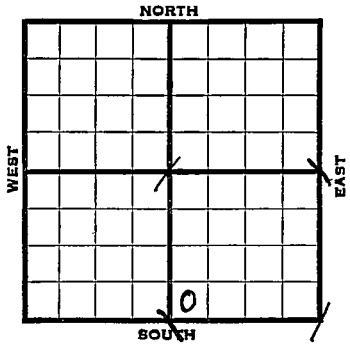

Elev. 1856

1939	REPORT
3/29	S. H.
4/7	10" - 211' Anhy 705'
	Drlg. 1507'
4/14	Topeka 2645' S.S.O. 2845-50'
	Lans. 2995' Drlg. 3060'
4/21	S.S.O. 3185-98' Cong. 3290'
	Arb. 3319' Core 3327-45,
	15' recovery. porous Dolo.
	S. O. & W. T.D. 3359' S.D.O.
4/26	Arb. 3319'
	T. D. 3359' S.O. & W.
	ABANDONED

Form 26—1M Bks.—2-29

Barton KANSAS

Map No. 55 Sec. 8 Twp. 16 R. 11W

Well No. 1 Ney

Transwestern Company

Contractor

FIRST REPORT

SW SE

_____ Ft. from N. Line


330 Ft. from S. Line

_____ Ft. from E. Line

330 Ft. from W. Line

WILDCAT

SECTION PLAT

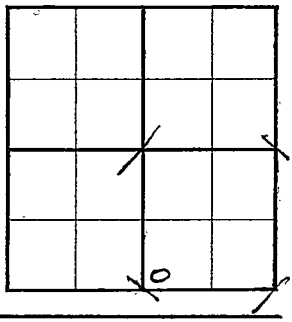

Location _____

Rig up _____

Drilling and Remarks:

S.H.

RECORD

Cased _____ in., _____ ft.

Sand _____

Gas _____

Oil _____

Total Depth _____

PRODUCTION

1st 24 hrs. Nat. _____

1st 24 hrs. after shot _____

Gas _____ Cu. Ft.

Dry Hole _____

Abandoned _____

Date

MAR 29 1939 19 H. D. Hatfield Scout

Form 26—1M Bks.—2-29 Barton KANSAS

Map No. 55 Sec. 8 Twp. 16 R. 11W

Well No. 1 Ney

Transwestern Company

Contractor

ABANDONED

SW SE

Ft. from N. Line


330 Ft. from S. Line

Ft. from E. Line

330 Ft. from W. Line

WILDCAT

SECTION PLAT

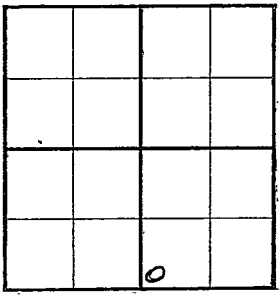

Location

Rig up

Drilling and Remarks:

S.O.&W.

D&A

RECORD

Cased in., ft.

Sand Arb 3319

Gas

Oil

Total Depth 3359

PRODUCTION

1st 24 hrs. Nat.

1st 24 hrs. after shot

Gas Cu. Ft.

Dry Hole

Abandoned

Date

APR 26 1939 19 H. D. Hatfield Scout