

KANSAS

FORM 51, 5M PETROL

Barton

Section 8 Township 16 Range 11-W

Well No. #2 ~~Ney~~

Company Cities Service Oil

NORTH

WEST

EAST

SOUTH

0

Sec. 8 Twp. 16 R. 11-W

Well No. #2 Ney Farm

Cities Service Oil Company


 Ft. from N. Line

330 Ft. from S. Line

990 Ft. from E. Line

 Ft. from W. Line

Elev. 1857

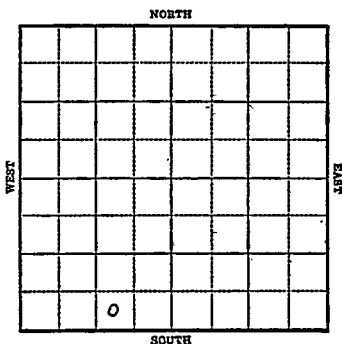

1943

R E P O R T

10/13 8" @ 313'
WOC

10/20 Topeka 2671
Lans 3001
Drlg. 3160

10/27 Arb 3293
5" @ 3295
T.D. 3298-200' in 13 hrs.

11/3 T.D. 3303 350 acid 180' oil
in 2 hrs.

11/10 2000 acid ount 3 oil & 90 water in
11 hrs
SD

11/17 PB 3264

11/24 5"@ 3295'
Arb. 3293
Water
TD 3303'

ABANDONED


KANSASMap No. 55 Sec. 8 Twp. 16 R. 11WWell No. 2 Ney

Cities Service Oil Company

FIRST REPORT

Contractor

SW SE SW

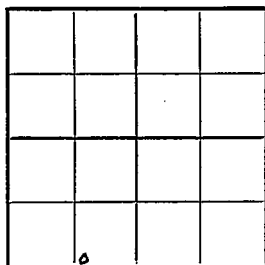SECTION PLAT

_____ Ft. from N. Line

330 Ft. from S. Line990 Ft. from E. Line

_____ Ft. from W. Line

Kraft Prusa Pool

Location _____

Rig up _____

Drilling and Remarks:

8"-313 WOC**RECORD**

Cased _____ in., _____ ft.

Sand _____

Gas _____

Oil _____

Total Depth _____

PRODUCTION

1st 24 hrs. Nat. _____

1st 24 hrs. after shot _____

Gas _____ Cu. Ft.

Dry Hole _____

Abandoned _____

Date

OCT 13 1943 19S. I. LEWIS Scout

Map No. 11 Sec. 8 Twp. 16 R. 11W

Well No. 2 Ney

Cities Service Oil Company

ABANDONED

Contractor

SW SE SW

SECTION PLAT

 Ft. from N. Line

330 Ft. from S. Line

990 Ft. from E. Line

 Ft. from W. Line

Kraft Prusa Pool

Location

Rig up

Drilling and Remarks:

Cr 8293

5" @ 3295

Water

RECORD

Cased in., ft.

Sand

Gas

Oil

Total Depth 3303

PRODUCTION

1st 24 hrs. Nat.

1st 24 hrs. after shot

Gas Cu. Ft.

Dry Hole

Abandoned

Date

NOV 24 1943 19 S. J. LEWIS Scout