Barton

KANSAS

SECTION 8 TOWNSHIP 16S RANGE 11W

WELL NO. #1-Ney

COMPANY Petroleum, Inc.

SE SW SE

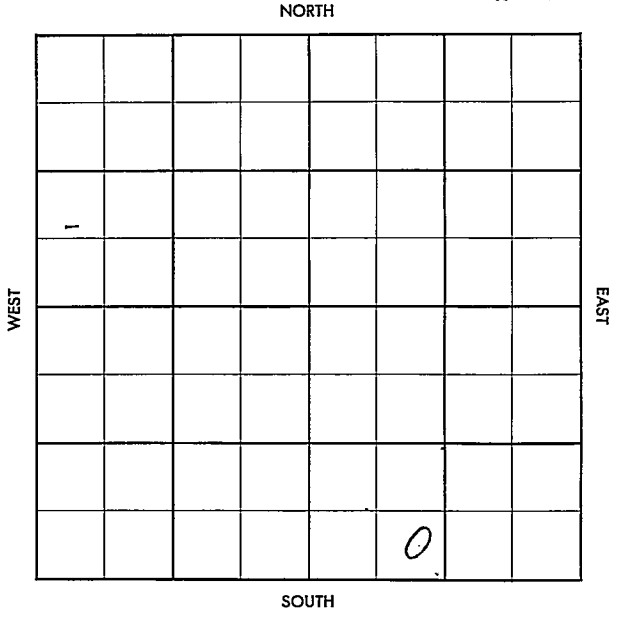

FORM 504-3 SUNRAY

FORM 513 SUNRAY

County Barton Elev.

Sec. 8 Twp. 16 Rge. 11W

Company Petroleum Inc.

Farm Name Ney No. 1

TOPS	DEPTH	LOG	DATUM
Anh.	700		
T.P.			
H.			
Tr.			
Dg.			
Bl.			
L.			
K.C.			
B.K.C.			
Ce.			
C.			
M.			
M.			
K.			
Mz.			
Mq.			
V.			
S.			
S.			
A			
R.			
P€.			
G.			
T.D.			

Loc. in Sec. SE SW SE

Geol.

Contr. Garvey Tools

Pool Kraft-Prusa

FIRST REPORT

JUL 24 '57

Date Comm. 7-19-57

8" @ 278/150, Drlg. 1775

Co.

No.

Sec.

T.

R.

FORM 513 SUNRAY

County Barton Elev. 1837 Co.

Sec. 8 Twp. 16 Rge. 11W

Company Petroleum Inc.

Farm Name Ney No. 1

TOPS	DEPTH	LOG	DATUM
Anh.	700		
Tp.			
H.	2875		
Tr.	2892		
Dg. Sh	2904		
Bl.	2965		
L.	2983		
K.C.			
B.K.C.			
Ce.			
C.			
M.			
M.			
K.			
Mz.			
Mo.			
V.			
S.			
S.			
A	3279		
R.			
Pe.			
G.			
T.D.	3320		

Loc. in Sec. SE SW SE

Geol.

Contr. Garvey Tools Lse.

Pool Kraft-Prusa

COMPLETE

AUG 7 '57

No.

Date Comm. 7-19-57 Sec.

8" @ 278/150, Drlg. 1775 DST T.

2984-3061 1hr rec. 205' Md

BHP 480/20 DST 3072-80 op R.

1hr rec 35' SOE GCWM BHP

600/20" DST 3072-90 op 1hr

rec 90' WM BHP 480/20" DST

3140-3250 1hr rec 60' Md BHP

360/20" DST 3281-3310 1hr rec

120' GIP + 2027' 95% oil + 1003'

FORM 513-I SUNRAY

Frgyoil FP 480-960 BHP
1030/20" 5½ 3318/64 AUG 8 '77
CO 3315 16/3283-87 $ Av.
4 Bopl no/w 2200' O.B. Pot
P. 25 Bopd no/w

8-26-11W

se sw se