

Section 8 Township 16 Range 11W

Well No. 2 Ney "A"

Company Lewis Drlg.

Kraft-Prusa
NORTH

WEST

EAST

SOUTH

Barton KANSAS ✓

Sec. 8 Twp. 16 R. 11W

Well No. #2. Ney "A" Farm

Lewis Drlg.


Kraft-Prusa Pool (Lewis Drlg. ^{NORTH} Cont.) Company

990' Ft. from N. Line

 Ft. from S. Line

1090' Ft. from E. Line

 Ft. from W. Line

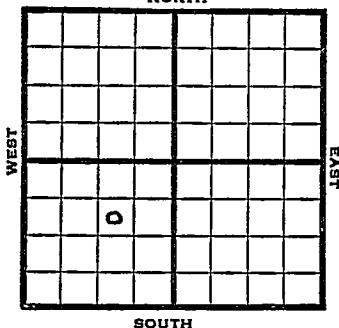

SW NE SW

1949 elev 1846' REPORT

8/31 8" @ 189'
Drlg. 1580'

9/7 Lansing 2992' Arbuckle 3300'
TD 3303'
5" @ 3300'

9/14 Swb 2½ bbls oil PH 6 hrs.

9/21 "

9/28 TD 3303'
Arb. 3300'
52@ 3300'
Pump 183 Oil Pot
42° Gr.
Comp

COMPLETED

Map No. _____ Sec. 8 Twp. 16 R. 11W

Well No. 2 Nev "A"

Lewis Drlg.

Company

Lewis Drlg.

Contractor

SW NE SW


FIRST REPORT
SECTION PLAT

990 Ft. from N. Line

Ft. from S. Line

1090 Ft. from E. Line

Ft. from W. Line

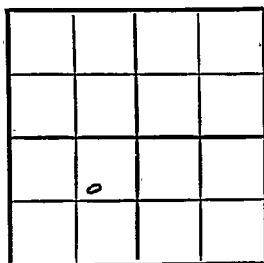

Barton County

Location

Rig up

Drilling and Remarks:

8" @ 189

drlg. 1580

RECORD

Cased _____ in., _____ ft.

Sand _____

Gas _____

Oil _____

Total Depth _____

PRODUCTION

1st 24 hrs. Nat. _____

1st 24 hrs. after shot _____

Gas _____ Cu. Ft.

Dry Hole _____

Abandoned _____

Date

AUG 31 1949 19

S. J. LEWIS

Scout

Kansas

Map No. _____ Sec. 8 Twp. 16 R. 11W

Well No. 2 Nev "A"

Lewis Drle. _____ Company

COMPLETE

Contractor

SW NE SW


E 11846
SECTION PLAT

990 Ft. from N. Line

Ft. from S. Line

1090 Ft. from E. Line

Ft. from W. Line

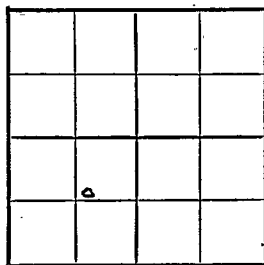

Barton County

RECORD

Location _____

Cased _____ in., _____ ft.

Rig up _____

Sand _____

Drilling and Remarks:

Gas _____

Oil _____

Total Depth 3353

PRODUCTION

1st 24 hrs. Nat. _____

1st 24 hrs. after shot _____

Gas _____ Cu. Ft.

Dry Hole _____

Abandoned _____

Date

SEP 28 1949

19

LEWIS

Scout