
Barton KANSAS

Form 51—5M—4-36—Palace

Section 9 Township 16 Range 11-W

Well Number 1 Davidson "A"

Company Sinclair-Prairie

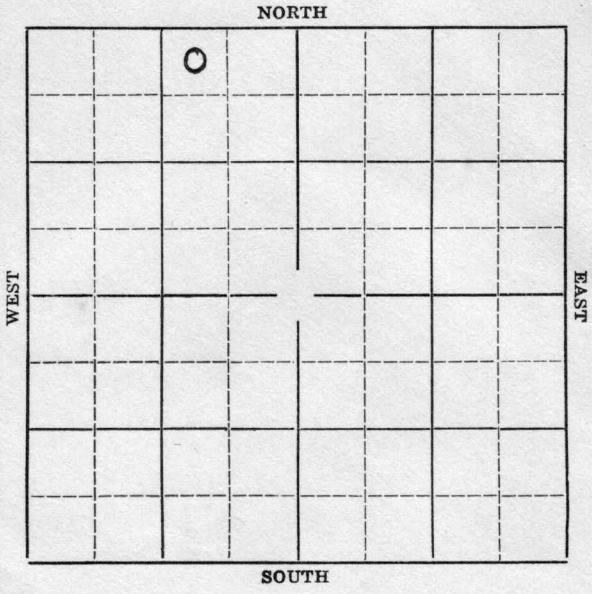

Form 252-A—5M—2-37—Palace KANSAS Barton

Sec. 9 Twp. 16 R. 11-W

Well No. #1 Davidson "A" Farm

Sinclair-Prairie Company


330 Ft. from N. Line

Ft. from S. Line

990 Ft. from E. Line

Ft. from W. Line

Elev. 1814

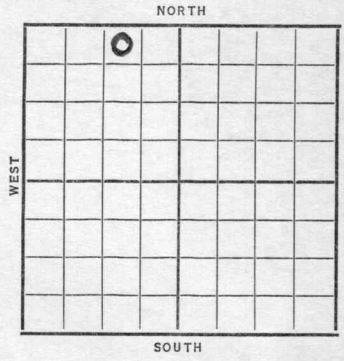

Date	REPORT
1937	
4/21	Location
4/30	"
5/7	Rigg. Rot.
5/14	15" @ 240'. Drlg. 1080'.
5/21	Drlg. 2560'.
5/26	Sil. 3343'.
	T.D. 3358'.
	ABANDONED

Form 26—1M Bks.—2-29 KANSAS Barton


Map No. 54 Sec. 9 Twp. 16 R. 11W

Well No. 1 Davidson "A"

Sinclair-Prairie Company

Contractor

SECTION PLAT

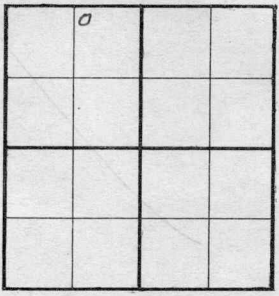

330 Ft. from N. Line

Ft. from S. Line

990 Ft. from E. Line

Ft. from W. Line

FIRST REPORT

Location ✓

Rig up

Drilling and Remarks:

RECORD

Cased in., ft.

Sand

Gas

Oil

Total Depth

PRODUCTION

1st 24 hrs. Nat.

1st 24 hrs. after shot

Gas Cu. Ft.

Dry Hole

Abandoned

Date

APR 21 1937

19

S. J. LEWIS Scout

Form 26—1M Bks.—2-29 Barton KANSAS

Map No. 55 Sec. 9 Twp. 16 R. 11 W

Well No. 1 – Davidson "A"

Sinclair Prairie Company

Contractor

ABANDONED


330 Ft. from N. Line

Ft. from S. Line

990 Ft. from E. Line

Ft. from W. Line

SECTION PLAT

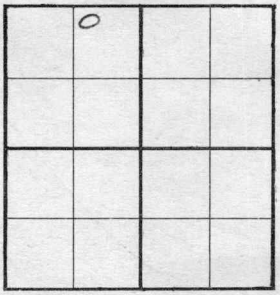

Location

Rig up

Drilling and Remarks:

D & A

RECORD

Cased in., ft.

~~Sand~~ S/1 3343

Gas

Oil

Total Depth 3358

PRODUCTION

1st 24 hrs. Nat.

1st 24 hrs. after shot

Gas Cu. Ft.

Dry Hole

Abandoned

Date

MAY 26 1937 19

H. D. Hatfield Scout