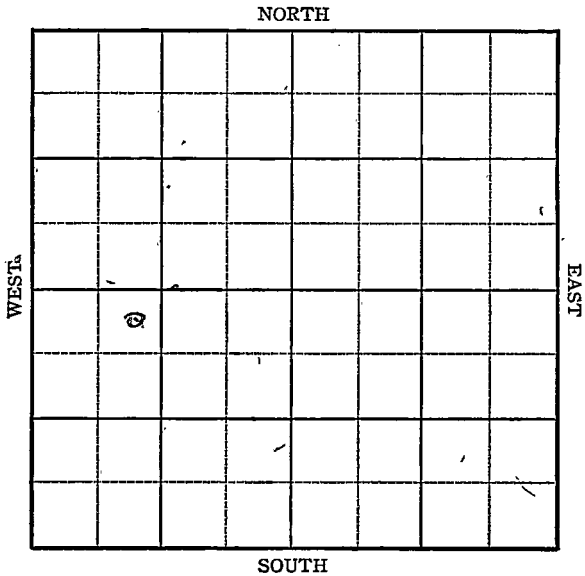


KANSAS

Section 9 Township 16 Range 11WWell No. 1 Davidson "B"Company Black-Marshall

KANSAS

Barton County

Sec. 9 Twp. 16 R. 11W

Well No. #1 Davidson "B" Farm

Black-Marshall

Company


Kraft-Prusa

330 Ft. from N. Line

Ft. from S. Line

Ft. from E. Line

990 Ft. from W. Line

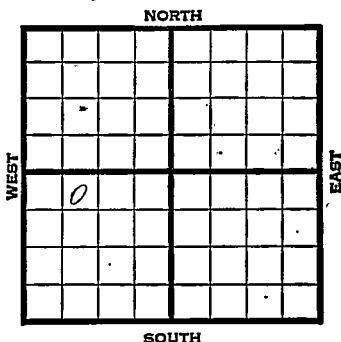

NE NW SW

Elev. 1787

REPORT

1945

7/11 8" @ 200'
Drlg. 1905'
7/19 Anh'y 645-
Lans 2936
Cong 3227
Drlg. 3277'
7/25 Cong. 3227
3278' in Cong. TD


ABANDONED

KANSAS ~~Kansas~~ Pool Name Kraft-PrusaMap No. 55 Sec. 9 Twp. 16 R. 11WWell No. 1 Davidson "B"Black-Marshall CompanyFIRST REPORT

Contractor

NE NW SW

SECTION PLAT

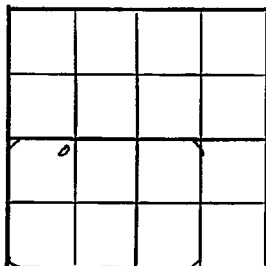330 Ft. from N. Line Ft. from S. Line Ft. from E. Line990 Ft. from W. LineBarton CountyLocation Rig up

Drilling and Remarks:

8"-2001905'

RECORD

Cased in., ft.Sand Gas Oil Total Depth

PRODUCTION

1st 24 hrs. Nat. 1st 24 hrs. after shot Gas Cu. Ft.Dry Hole Abandoned

Date

JUL 1 1 1945 19S. J. LEWIS

Scout

"ANSAS" Kansas Pool Name Kraft-PrusaMap No. 9 S Sec. 9 Twp. 16 R. 11 WWell No. 1 Davidson "B"Black-Marshall

Company

ABANDONED

Contractor

NE NW SW

E 1.1787

SECTION PLAT

330 Ft. from N. Line Ft. from S. Line Ft. from E. Line990 Ft. from W. Line

0			

Barton County

Location

Rig up

Drilling and Remarks:

Cong 8227
3278 in Cong.

RECORD

Cased in., ft.Sand Gas Oil Total Depth 3278

PRODUCTION

1st 24 hrs. Nat. 1st 24 hrs. after shot Gas Cu. Ft.Dry Hole Abandoned

Date

JUL 2 5 1945 19S. J. LEWIS

Scout