


Section 10 Township 16 Range 11-W

Well Number 1-Redetzke

Company Rose & Lent

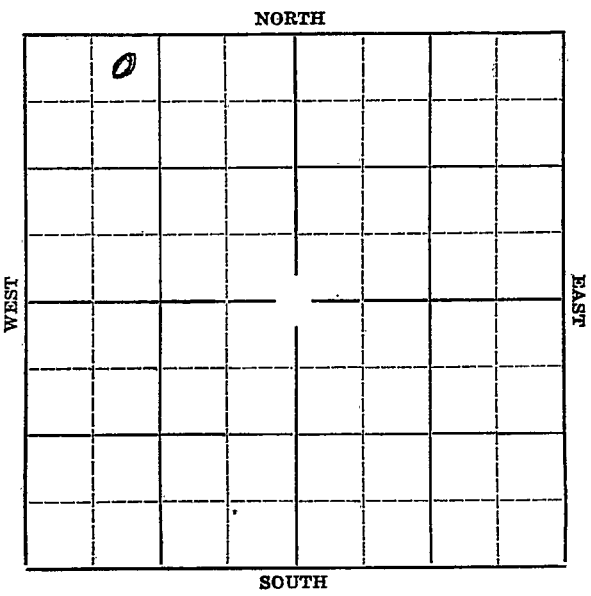

Map No.                      Sec. 10 Twp. 16 R. 11-W

Well No. 1-Redetzke - Farm

Rose & Lent Company


330 Ft. from N. Line

                     Ft. from S. Line

                     Ft. from E. Line

990 Ft. from W. Line

Elev. 1877

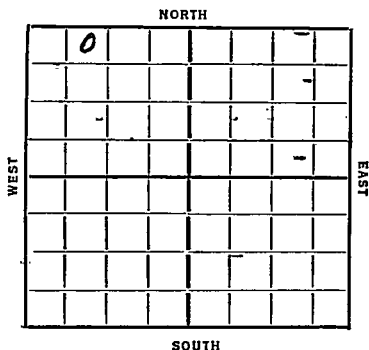

Date	REPORT
1936	
4/15	R.O.G.
4/23	--
4/30	Rig.
5/7	Rigging up.
5/14	-- 5/21-- 5/28--
6/4	Spud.
6/11	Drlg. 365'.
6/18	Drlg. 510'.
6/25	Anhy. 700' drlg.
7/2	Shut down.
7/9	10" @ 715'.
7/16	Drlg. 735'.
7/23	Drlg. 1115'.
7/30	Drlg. 1760'.
8/6	Drlg. 1970'.
8/13	10" @ 2026'. Drlg. 2350'.
8/20	Topeka 2615'. Drlg. 2845'.
8/27	Drlg. 2889'.
9/3	Kansas City 3020'. Show oil 3030'
	to 35'. Oil 3090-3101'. TD 3108'.
	1½ bailers of oil per hour.

**OVER**

- 9/10-~~3108-9~~ 3108-10', 9 bailers of oil  
per hour. T.D. 3175', 800' of oil  
in hole.
- 9/18-5" @ 3200', Drlg. 3237'.
- 9/24-Conglomerate 3312'. Sil. 3326'.  
T.D. 3330'. 4 bailers of oil per hr
- 10/1-Under ream 5" @ 3294'.
- 10/7/36-Sil. 3326'.  
Hole full of water. 3342'.  
T.D. 3346'.  
Dry and abandoned.

**ABANDONED**

TEXAS

Map No. 53 Sec. 18 Twp. 16 R. 11WWell No. Red et alRose & Leach Company

Contractor

## SECTION PLAT

320 Ft. from N. Line

..... Ft. from S. Line

..... Ft. from E. Line

990 Ft. from W. Line

0			

## FIRST REPORT

Location.....

Rig up.....

Drilling and Remarks:

ROG

## RECORD

Cased..... in., ..... ft.

Sand.....

Gas.....

Oil.....

Total Depth.....

## PRODUCTION

1st 24 hrs. Nat.....

1st 24 hrs. after shot.....

Gas..... Cu. Ft.

Dry Hole.....

Abandoned.....

Date

APR 15 1936

192.....

S. J. JAMES

Scout

Map No. 55 Sec. 10 Twp. 16 R. 11W

Well No. 1 Redetokas

Rose & Land Company

Contractor

SECTION PLAT


330 Ft. from N. Line

\_\_\_\_\_ Ft. from S. Line

\_\_\_\_\_ Ft. from E. Line

990 Ft. from W. Line

ABANDONED

Location \_\_\_\_\_

Rig up \_\_\_\_\_

Drilling and Remarks:

Sil 3326

N 17 W 3342

J & H

RECORD

Cased \_\_\_\_\_ in., \_\_\_\_\_ ft.

Sand \_\_\_\_\_

Gas \_\_\_\_\_

Oil \_\_\_\_\_

Total Depth 3346

PRODUCTION

1st 24 hrs. Nat. \_\_\_\_\_

1st 24 hrs. after shot \_\_\_\_\_

Gas \_\_\_\_\_ Cu. Ft.

Dry Hole \_\_\_\_\_

Abandoned \_\_\_\_\_

Date

OCT 7 1936 19

S. J. LEWIS Scout