


KANSAS Butler

Section 22 Township 25 Range 5EWell No. #34 KnoxCompany Cities Service

Miscellaneous

NORTH

WEST

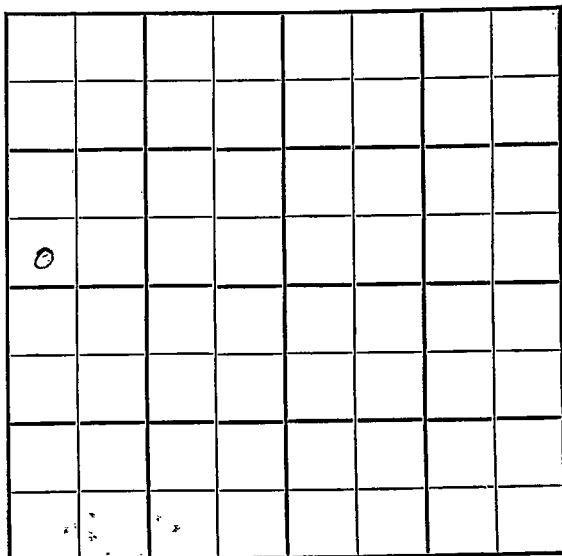

EAST

SOUTH

Sec. 22 Twp. 25 R. 5E

Well No. #34 Knox Farm

Cities Service Company

Misc.


Ft. from N. Line

330 Ft. from S. Line

Ft. from E. Line

330 Ft. from W. Line

SW NW

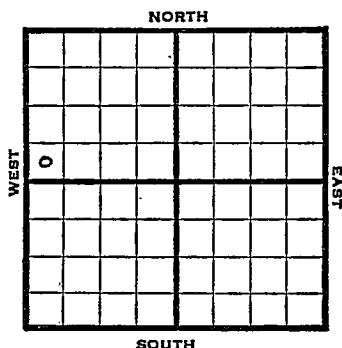

1947

Lev. 1362' REPORT

12/3

Location

12/10

8" @ 80'
Drlg. 2470'

12/17

Lans. 1665'
KC 1948'
Arb. 2479'
TD 2494'
5" @ 2480'

12/30

"

1948

1/7

2150' oil 13 hrs.

1/14

Pump 50 bbls oil 14 hrs

1/21

Arb. 2479'
5" @ 2480'
Pump 50 Pot
TD 2494'
Gr. 38.0
Comp.

COMPLETED

Map No. _____ Sec. 22 Twp. 25 R. 5E

Well No. 34 Knox

Cities Service Company

FIRST REPORT

Contractor

SW NW


SECTION PLAT

_____ Ft. from N. Line

330 Ft. from S. Line

_____ Ft. from E. Line

330 Ft. from W. Line

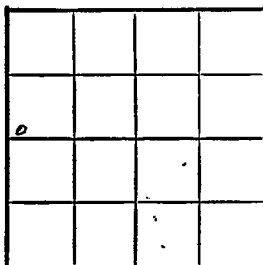

Butler County

Location X

Rig up _____

Drilling and Remarks:

RECORD

Cased _____ in., _____ ft.

Sand _____

Gas _____

Oil _____

Total Depth _____

PRODUCTION

1st 24 hrs. Nat. _____

1st 24 hrs. after shot _____

Gas _____ Cu. Ft.

Dry Hole _____

Abandoned _____

Date

DEC 3 1947

19

S. J. LEWIS Scout

Map No. 14 Sec. 22 Twp. 25 R. 5EWell No. 34 KnoxCities Service Company


COMPLETE

Contractor

SW NW

F 11362

SECTION PLAT

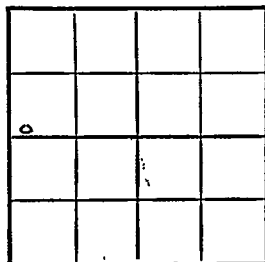 Ft. from N. Line

330

 Ft. from S. Line Ft. from E. Line

330

 Ft. from W. Line

Butler County

Location Rig up

Drilling and Remarks:

*Art 2479**5" @ 2480**Pump 500 ft**380 ft*

RECORD

Cased in., ft.Sand Gas Oil ✓Total Depth 2494

PRODUCTION

1st 24 hrs. Nat. 1st 24 hrs. after shot Gas Cu. Ft.Dry Hole Abandoned

Date

JAN 21 1948

19

S. J. LEWIS

Scout