

Barton KANSAS

Section 11 Township 16 Range 11-W

Well No. #1 Montgomery

Company C.E.Ash & Crown Petroleum

NORTH Wildcat

WEST	0							

EAST

SOUTH

KANSAS


Barton

Sec. 11 Twp. 16 R. 11-WWell No. #1 Montgomery FarmC. E. Ash & Crown Petr. Company

(Wildcat)

330 Ft. from N. Line Ft. from S. Line Ft. from E. Line330 Ft. from W. Line

Elev. 1871

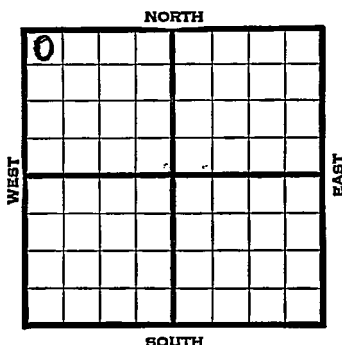

1939	REPORT
8/9	Ponds.
8/17	"
8/24	Cable rig.
8/31	" "
9/7	" "
9/14	" "
9/21	" "
9/28	" "
10/5	" "
10/12	Rigging up.
10/19	Drlg. 370'
10/26	Anhy 697' 12 $\frac{1}{2}$ " - 705'
	Drlg. 725'
11/2	Drlg. 1580'
11/9	10" - 1979' Drlg. 2020'
11/16	8" - 2380' T.D. 2467' U.R. 8".
11/23	2760' underdigging 8".
11/29	Topeka 2658' 8" - 2848'
	Lans. 3029' T.D. 3045'
	U.R. 8".
	OVER

1939

12/7 Arb. 3393' H.F.W. Gorham 3399'
T.D. 3402' SD. . .

12/13 Gorham 3399'
Show dead oil.
T.D. 3422'

ABANDONED

Barton

KANSAS

Map No. 55 Sec. 11 Twp. 16 R. 11WWell No. 1 MontgomeryC. E. Ash & Crown Petroleum Company

Contractor

FIRST REPORT

NW/C

330 Ft. from N. Line

_____ Ft. from S. Line

_____ Ft. from E. Line

330 Ft. from W. Line

WILDCAT

SECTION PLAT

0			

Location _____

Rig up _____

Drilling and Remarks:

Ponds

RECORD

Cased _____ in., _____ ft.

Sand _____

Gas _____

Oil _____

Total Depth _____

PRODUCTION

1st 24 hrs. Nat. _____

1st 24 hrs. after shot _____

Gas _____ Cu. Ft.

Dry Hole _____

Abandoned _____

Date

AUG 9 1939

19

S. J. LEWIS Scout

Barton

KANSAS

Map No. 55 Sec. 11 Twp. 16 R. 11WWell No. 1 MontgomeryC. E. Ash & Crown Petroleum Company

Contractor

ABANDONED
NW/C330 Ft. from N. Line

_____ Ft. from S. Line

_____ Ft. from E. Line

330 Ft. from W. Line

SECTION PLAT

0			

WILDCAT

Location _____

Rig up _____

Drilling and Remarks:

*Boham 3399**show dead oil*

RECORD

Cased _____ in., _____ ft.

Sand _____

Gas _____

Oil _____

Total Depth 3422

PRODUCTION

1st 24 hrs. Nat. _____

1st 24 hrs. after shot _____

Gas _____ Cu. Ft.

Dry Hole _____

Abandoned _____

Date

DEC 13 1939 19

S. J. LEWIS Scout