

Barton County

Kraft-Prusa


FORM 51 IOM 12-46 PETROL

KANSAS

Section 12 Township 16 Range 11W

Well No. 1 Horejesi

Company Sohio etal.

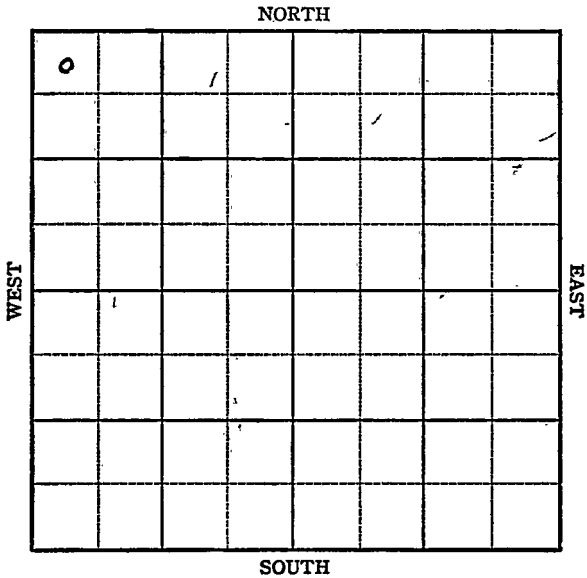

Sec. 12 Twp. 16 R. 11-W

Well No. #1 Horejesi Farm

Sohio etal Company  
Kraft-Prusa

330 Ft. from N. Line


\_\_\_\_\_ Ft. from S. Line

\_\_\_\_\_ Ft. from E. Line

330 Ft. from W. Line

NW/C

Elev. 1866'

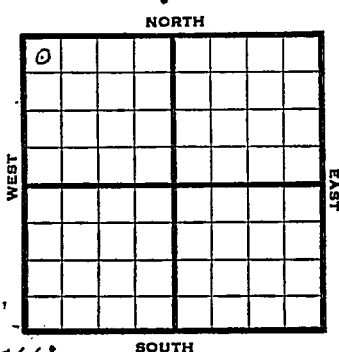

1947

REPORT

2/26	RUR		
3/4	"		
3/11	8" @ 367'		
	Drlg 1675'		
3/18	Drlg 2740'		
3/25	Arb 3340'		
	TD 3346'		
	5" @ 3340'		
	RUST		
4/2	Drlg. 3362'.		
4/9	PB 3088		
	24 shots 3039-46	4000 Acid	
	Swb 1 oil & 1 BW	in 16 hrs	
4/15	"	"	"
4/23	"	"	"
4/29	"	"	"
5/7	"	"	"
5/13	TD 3362'		

**OVER**

5/20 1000 acid 3096'-3100

5/27 Squeeze..

6/4 Arb. 3340'  
5" @ 3340'  
TD 3346'

**ABANDONED**

Kansas KANSAS

Map No. 55 Sec. 12 Twp. 16 R. 11WWell No. 1 HorejesiSohio etal. Company

## FIRST REPORT

Contractor


NW/C

## SECTION PLAT

330 Ft. from N. Line

\_\_\_\_\_ Ft. from S. Line

\_\_\_\_\_ Ft. from E. Line

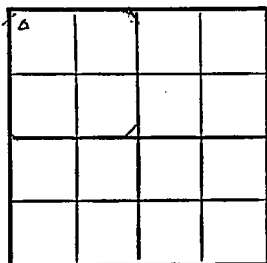330 Ft. from W. Line

Barton County

Location \_\_\_\_\_

Rig up \_\_\_\_\_

Drilling and Remarks:

R U R

## RECORD

Cased \_\_\_\_\_ in., \_\_\_\_\_ ft.

Sand \_\_\_\_\_

Gas \_\_\_\_\_

Oil \_\_\_\_\_

Total Depth \_\_\_\_\_

## PRODUCTION

1st 24 hrs. Nat. \_\_\_\_\_

1st 24 hrs. after shot \_\_\_\_\_

Gas \_\_\_\_\_ Cu. Ft.

Dry Hole \_\_\_\_\_

Abandoned \_\_\_\_\_

Date

FEB 26 1947 19

S. J. LEWIS Scout

Map No. 55 Sec. 12 Twp. 16 R. 11W

Well No. 1 Horejesi

Sohio etal. Company

**ABANDONED**

Contractor

NW/C

E. I. 1866

SECTION PLAT

330 Ft. from N. Line

\_\_\_\_\_ Ft. from S. Line

\_\_\_\_\_ Ft. from E. Line

330 Ft. from W. Line

6			

Barton County

**RECORD**

Location \_\_\_\_\_

Cased \_\_\_\_\_ in., \_\_\_\_\_ ft.

Rig up \_\_\_\_\_

Sand \_\_\_\_\_

Drilling and Remarks:

Gas \_\_\_\_\_

CR 43340

Oil \_\_\_\_\_

5" @ 3340

Total Depth 3346

**PRODUCTION**

1st 24 hrs. Nat. \_\_\_\_\_

1st 24 hrs. after shot \_\_\_\_\_

Gas \_\_\_\_\_ Cu. Ft.

Dry Hole \_\_\_\_\_

Abandoned \_\_\_\_\_

Date

JUN 4 1947 19

S. J. LEWIS Scout